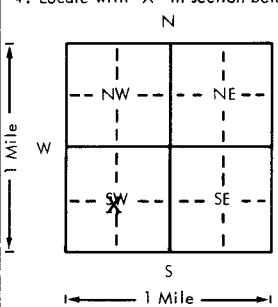


USE TYPEWRITER OR BALL
POINT PEN-PRESS FIRMLY,
PRINT CLEARLY.

WATER WELL RECORD
KSA 82a-1201-1215

Kansas Department of Health and
Environment-Division of Environment
(Water well Contractors)
Topeka, Kansas 66620

1. Location of well:		County Pratt	Fraction Center 1/4 1/4SW 1/4	Section number 11	Township number T 27 S R 15 E	Range number 15
2. Distance and direction from nearest town or city: 5 1/2 Miles NW of Cullison, KS Street address of well location if in city:			3. Owner of well: Byrne Vickers R.R. or street: 121 Ridge Crest City, state, zip code: Wichita, KS 67218			
4. Locate with "X" in section below: 			Sketch map: 6. Bore hole dia. 24 in. Completion date 4-20-78 Well depth 120 ft. Pump Set 5-8-78 7. <input type="checkbox"/> Cable tool <input type="checkbox"/> Rotary <input type="checkbox"/> Driven <input type="checkbox"/> Dug <input type="checkbox"/> Hollow rod <input type="checkbox"/> Jetted <input type="checkbox"/> Bored <input checked="" type="checkbox"/> Reverse rotary 8. Use: <input type="checkbox"/> Domestic <input type="checkbox"/> Public supply <input type="checkbox"/> Industry <input checked="" type="checkbox"/> Irrigation <input type="checkbox"/> Air conditioning <input type="checkbox"/> Stock <input type="checkbox"/> Lawn <input type="checkbox"/> Oil field water <input type="checkbox"/> Other 9. Casing: Material Steel Height Above or below Threaded <input type="checkbox"/> Welded <input checked="" type="checkbox"/> Surface 12 in. RMP <input type="checkbox"/> PVC <input type="checkbox"/> Weight 30.3 lbs./ft. Dia. 16 in. to 80 ft. depth Wall Thickness: inches or Dia. <input type="checkbox"/> in. to <input type="checkbox"/> ft. depth gage No. 7 ga.			
5. Type and color of material			From	To	10. Screen: Manufacturer's name Doerr Type Double-slot Dia. 16" Slot/gauze 1/8" Length 40' Set between 80 ft. and 120 ft. Gravel pack? yes Size range of material 3/8-200	
Top soil & sand			0	11	11. Static water level: 31' 6" below land surface Date 4-20-78	
Sand & clay			11	52	12. Pumping level below land surfaces: N/C ____ ft. after ____ hrs. pumping ____ g.p.m. ____ ft. after ____ hrs. pumping ____ g.p.m. Estimated maximum yield ____ g.p.m.	
Sand & gravel			52	117	13. Water sample submitted: ____ mo./day/yr. Yes <input checked="" type="checkbox"/> No <input type="checkbox"/> Date ____	
White clay			117	120	14. Well head completion: ____ Pitless adapter 12 Inches above grade	
					15. Well grouted? yes With: <input checked="" type="checkbox"/> Neat cement <input type="checkbox"/> Bentonite <input type="checkbox"/> Concrete Depth: From 0 ft. to 10 ft.	
					16. Nearest source of possible contamination: FIELD ft. ____ Direction ____ Type ____ Well disinfected upon completion? ____ Yes <input checked="" type="checkbox"/> No <input type="checkbox"/>	
					17. Pump: ____ Not installed Manufacturer's name Peerless Pump Co. Model number 12LB-3 HP 80 Volts ____ Length of drop pipe 80 ft. capacity 900 g.p.m. Type: ____ Submersible <input checked="" type="checkbox"/> Turbine ____ Jet ____ Reciprocating ____ Centrifugal ____ Other	
(Use a second sheet if needed)						
18. Elevation: Topography: ____ Hill ____ Slope ____ Upland ____ Valley		19. Remarks:		20. Water well contractor's certification: This well was drilled under my jurisdiction and this report is true to the best of my knowledge and belief. Clarke Well & Eq., Inc. 185 Business name Great Bend, KS 67530 License No. ____ Address 5-10-78 Signed [Signature] Date 5-10-78 Authorized representative		

Forward the white, blue and pink copies to the Department of Health and Environment

Form WWC-5