USE TYPEWRITER OR BALL POINT PEN-PRESS FIRMLY, PRINT CLEARLY.

WATER WELL RECORD
KSA 82a-1201-1215

Kansas Department of Health and Environment-Division of Environment
(Water well Contractors)
Topeka, Kansas 66620

1. Location of well:	County	Fraction	Section number	Township number	Range number
	Kiowa	1/4 c 1/4 se1/4	6	T 27 S	R 16 E/W

2. Distance and direction from neorest town or city: 6-3/4-N of Haviland, Ks. west side
Street address of well location if in city:

3. Owner of well: Gerald Tuttle
R.R. or street: none
City, state, zip code: Haviland, Kansas 67059

4. Locate with "X" in section below: Sketch map:

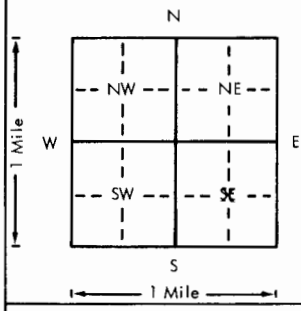

6. Bore hole dia. 29 in. Completion date
Well depth 177 ft. 2-13-75

7. __ Cable tool X Rotary __ Driven __ Dug
__ Hollow rod __ Jetted __ Bored __ Reverse rotary

8. Use: __ Domestic __ Public supply __ Industry
X Irrigation __ Air conditioning __ Stock
__ Lown __ Oil field water __ Other

9. Casing: Material Steel Height: Above or ~~Below~~
Threaded ____ Welded ____ Surface 18 in.
RMP ____ PVC ____ Weight ____ lbs./ft.
Dia. 16 in. to 177 ft. depth Wall Thickness: inches or
Dia. ____ in. to ____ ft. depth gage No. 7

10. Screen: Manufacturer's name Doerrs
Type steel Dia.
Slot/~~gaxx~~ 3/16 Length 60
Set between 117 ft. and 177 ft.
____ ft. and ____ ft.
Gravel pack? X Size range of material #3/4 3/8

11. Static water level: mo./day/yr.
16 ft. below land surface Date 12-3-74

12. Pumping level below land surfaces:
32 ft. after 1 hrs. pumping 800 g.p.m.
____ ft. after ____ hrs. pumping ____ g.p.m.
Estimated maximum yield 1600 g.p.m.

13. Water sample submitted: mo./day/yr.
X Yes ___ No Date 12-3-74

14. Well head completion:
___ Pitless adapter ____ Inches above grade

15. Well grouted? X
With: X Neat cement ____ Bentonite ____ Concrete
Depth: From 0 ft. to 10 ft.

16. Nearest source of possible contamination:
ft. 5/8mile direction south Type gaswell
Well disinfected upon completion? X Yes ____ No

17. Pump: ___ Nat instolled
Manufacturer's name W.L.R.
Model number 5-12CHC HP 80 Volts ____
Length of drop pipe 70 ft. capacity 1000 g.p.m.
Type:
___ Submersible X Turbine
___ Jet ___ Reciprocating
___ Centrifugal ___ Other

5. Type and colar of material	From	To
sandy top soil	0	2
brown sandy clay	2	4
fine sand	4	11
sandy brown gray clay & fine sand	11	27
sand & gravel clean coarse loose	27	47
sandy brown clay	47	53
sand & gravel clean coarse loose	53	75
brown clay	75	88
sand & gravel clean coarse loose	88	98
brown & white clay & white rock	98	105
fine sand & brown clay	105	111
sand & gravel clean coarse loose	111	126
brown clay w/sand	126	132
sand & gravel clean coarse loose	132	177
light gray white clay	177	180
yellow brown light gray clay	180	187

(Use a second sheet if needed)

18. Elevation:

Topography:
___ Hill
___ Slope
X Upland
___ Valley

19. Remarks:

20. Water well contractor's certification:
This well was drilled under my jurisdiction and this report is true to the best of my knowledge and belief.
Rosencrantz-Bemis 134
Business name License No.
Address Great Bend, Kansas 67530
X Signed S. Kilgore Date 6-19-79
Authorized representative

T 27 R 16 Sec 6 1/4 1/4 1/4 SE

Forward the white, blue and pink copies to the Department of Health and Environment

Form WWC-5

MT-1023