

USE TYPEWRITER OR BALL POINT PEN-PRESS FIRMLY, PRINT CLEARLY.


T R EW sec 1/4 1/4 1/4 No.

WATER WELL RECORD  
KSA 82a-1201-1215

Kansas State Dept. Of Health  
(Water Well Contractors)  
Forbes-Bldg, 740  
Topeka, Kansas 66620

1 Location of well:	County <b>Kiowa</b>	Township name	Fraction <b>SW<math>\frac{1}{4}</math></b>	Section number <b>24</b>	Town number <b>27</b>	Range number <b>16</b>
---------------------	------------------------	---------------	---	-----------------------------	--------------------------	---------------------------

Distance and direction from nearest town or city: Street address of well location if in city:	<b>4 mi North of Wellstford</b>	3 Owner of well: Address:	<b>Glenn Clarkson Haviland, Kansas</b>
--	---------------------------------	------------------------------	--

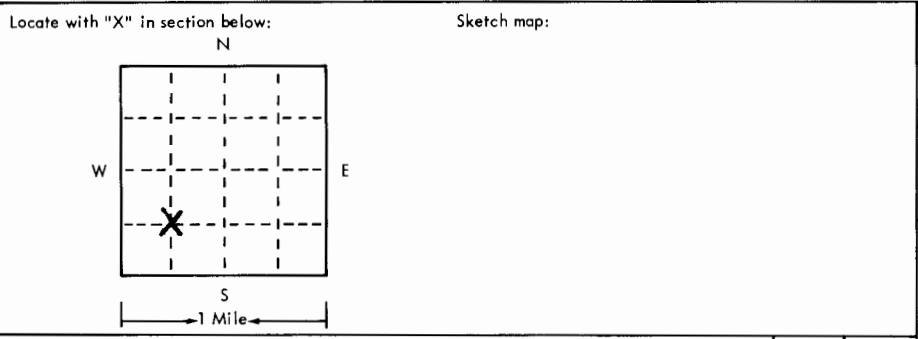

4 Well depth: 151 ft. Date of completion 3/30/75  
Well diameter 30 in.

5  Cable tool  Rotary  Driven  Dug  
 Hollow rod  Jetted  Bored  Reverse rotary

6 Use:  Domestic  Public supply  Industry  
 Irrigation  Air conditioning  Commercial  
 Test well

7 Casing: Material Stl Height: above/below  
Threaded  Welded  Surface 18 in.  
Diam. 16 in. to 96 ft. depth Weight 31.75 lbs./ft.  
Drive shoe?  Yes  No

2	Type and color of material	From	To
	Sandy top soil	0	2
	Fine sand	2	10
	Clay	10	60
	Med. to coarse sand & gravel w/some clay	60	85
	Clay	85	95
	Med. to coarse sand & fine gravel	95	105
	Sandy clay	105	110
	Med. to coarse sand & gravel	110	120
	Clay	120	124
	Sand rocks - hard	124	126
	Clay	126	144
	Fine to coarse sand	144	150
	Clay	150	152
	(use a second sheet if needed)		

8 Screen:  
Manufacturer Doerr  
Type Stl Dia. 16"  
Slot/gauze 1/8 Length 55'  
Set between 96 ft. and 151 ft.  
Fittings:  
Gravel pack  Yes  No Size range of material 1/8" x 3/8"

9 Static water level:  
41.10 ft. below land surface Date 3/30/75

10 Pumping level below land surfaces:  
78.75 ft. after 4 hrs. pumping 800 g.p.m.  
\_\_\_\_ ft. after \_\_\_\_ hrs. pumping \_\_\_\_ g.p.m.  
Estimated maximum yield 800 g.p.m.

11 Water sample submitted:  
 Yes  No Date \_\_\_\_\_

12 Well head completion:  
 Pitless adapter  12 Inches above grade

13 Well grouted?  Yes  No  
 Neat cement  Bentonite  Clay  
Depth: From 0 ft. to 15 ft.

14 Nearest source of possible contamination: None known  
ft. \_\_\_\_\_ Direction \_\_\_\_\_ Type \_\_\_\_\_  
Well disinfected upon completion?  Yes  No

15 Pump:  Not installed  
Manufacturer's name Layne  
Model number 12RL HP 75 Volts \_\_\_\_\_  
Length of drop pipe 100 ft. capacity 700 g.p.m.  
Type:  
 Submersible  Turbine  
 Jet  Reciprocating  
 Centrifugal  Other

16 Remarks: elevation

Topography:  
 Hill  
 Slope  
 Upland  
 Valley

17 Water well contractor's certification:  
This well was drilled under my jurisdiction and this report is true to the best of my knowledge and belief.

**Layne Western Co.** 102  
Business name \_\_\_\_\_ License No. \_\_\_\_\_  
Address Wichita, Kansas  
Signed [Signature] Date 3/31/75  
Authorized Representative

Forward the white, blue and pink copies to the Kansas State Dept. Of Health.

Form WWC-5