


1 LOCATION OF WATER WELL: Fraction  $\frac{1}{4}$   $\frac{1}{4}$  C SW  $\frac{1}{4}$  Section Number 30 Township Number T 27 S Range Number R 16 W E/W

Distance and direction from nearest town or city street address of well if located within city?  
 3N 3/4W 1/4N of Haviland, Kansas

2 WATER WELL OWNER: Ron Taylor  
 RR#, St. Address, Box #: RR 1 Board of Agriculture, Division of Water Resources  
 City, State, ZIP Code: Haviland, Kansas 67059 Application Number: 36,986

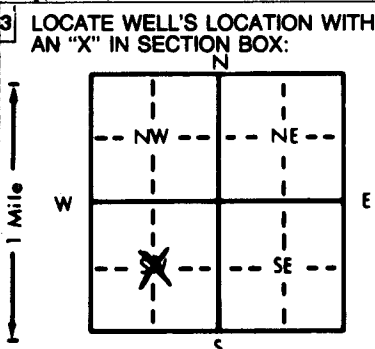

4 DEPTH OF COMPLETED WELL: 137 ft. ELEVATION: .....ft.  
 Depth(s) Groundwater Encountered 1. 56 ft. 2. ....ft. 3. ....ft.  
 WELL'S STATIC WATER LEVEL: 53 ft. below land surface measured on mo/day/yr 17 Jan 86  
 Pump test data: Well water was 63.1 ft. after 1 hours pumping 1000 gpm  
 Est. Yield .1600 gpm: Well water was 66.2 ft. after 1 hours pumping 1200 gpm  
 Bore Hole Diameter: 30 in. to 137 ft., and .....in. to .....ft.  
 WELL WATER TO BE USED AS:  
 5 Public water supply 8 Air conditioning 11 Injection well  
 1 Domestic 3 Feedlot 6 Oil field water supply 9 Dewatering 12 Other (Specify below)  
 xx2 Irrigation 4 Industrial 7 Lawn and garden only 10 Observation well  
 Was a chemical/bacteriological sample submitted to Department? Yes.....No...X.....; If yes, mo/day/yr sample was submitted  
 Water Well Disinfected? Yes X No

5 TYPE OF BLANK CASING USED:  
 xx1 Steel 3 RMP (SR) 5 Wrought iron 8 Concrete tile CASING JOINTS: Glued ..... Clamped .....  
 2 PVC 4 ABS 6 Asbestos-Cement 9 Other (specify below) Welded X .....  
 7 Fiberglass Threaded .....  
 Blank casing diameter: 16 in. to 77 ft., Dia. ....in. to .....ft., Dia. ....in. to .....ft.  
 Casing height above land surface: 12 in., weight 42.05 lbs./ft. Wall thickness or gauge No. 250  
 TYPE OF SCREEN OR PERFORATION MATERIAL:  
 xx1 Steel 3 Stainless steel 5 Fiberglass 7 PVC 10 Asbestos-cement  
 2 Brass 4 Galvanized steel 6 Concrete tile 8 RMP (SR) 11 Other (specify) .....  
 9 ABS 12 None used (open hole)  
 SCREEN OR PERFORATION OPENINGS ARE:  
 1 Continuous slot 3 Mill slot 5 Gauzed wrapped 8 Saw cut 11 None (open hole)  
 2 Louvered shutter xx4 Key punched 6 Wire wrapped 9 Drilled holes  
 7 Torch cut 10 Other (specify) .....  
 SCREEN-PERFORATED INTERVALS: From 77 ft. to 137 ft., From .....ft. to .....ft.  
 From .....ft. to .....ft., From .....ft. to .....ft.  
 GRAVEL PACK INTERVALS: From 10 ft. to 137 ft., From .....ft. to .....ft.  
 From .....ft. to .....ft., From .....ft. to .....ft.

6 GROUT MATERIAL: 1 Neat cement 2 Cement grout xx3 Bentonite 4 Other .....  
 Grout intervals: From 0 ft. to 10 ft., From .....ft. to .....ft., From .....ft. to .....ft.  
 What is the nearest source of possible contamination:  
 1 Septic tank 4 Lateral lines 7 Pit privy 10 Livestock pens 14 Abandoned water well  
 2 Sewer lines 5 Cess pool 8 Sewage lagoon 11 Fuel storage 15 Oil well/Gas well  
 3 Watertight sewer lines 6 Seepage pit 9 Feedyard 12 Fertilizer storage 16 Other (specify below)  
 13 Insecticide storage .....NONE  
 Direction from well? How many feet?

FROM	TO	LITHOLOGIC LOG	FROM	TO	LITHOLOGIC LOG
0	2	Soil, sandy			
2	24	Sand, fine with clay			
24	38	Clay, brown sandy			
38	44	Sand, fine to coarse & fine gravel			
44	56	Clay, brown sandy			
56	78	Sand, fine to coarse & med gravel			
78	81	Clay, tan			
81	96	Sand, med to coarse & med to very coarse gravel			
96	100	Clay, tan			
100	122	Sand, med to coarse & med to coarse gravel			
122	126	Clay, tan sandy			
126	137	Sand, med to coarse and med to coarse gravel			
137	139	Shale, multi colored			

7 CONTRACTOR'S OR LANDOWNER'S CERTIFICATION: This water well was (1) constructed, (2) reconstructed, or (3) plugged under my jurisdiction and was completed on (mo/day/year) 17 Jan 86 and this record is true to the best of my knowledge and belief. Kansas Water Well Contractor's License No. 325 This Water Well Record was completed on (mo/day/yr) 25 Jan 86 under the business name of Central Well and Pump by (signature) [Signature]

INSTRUCTIONS: Use typewriter or ball point pen. PLEASE PRESS FIRMLY and PRINT clearly. Please fill in blanks, underline or circle the correct answers. Send top three copies to Kansas Department of Health and Environment, Office of Oil Field and Environmental Geology, Regulation and Permitting Section, Topeka, Kansas 66620-7500, Telephone: 913-862-9360. Send one to WATER WELL OWNER and retain one for your records.

OFFICE USE ONLY  
T  
R  
EW  
SEC.