


1 LOCATION OF WATER WELL: Fraction C 8/2 1/4 SE 1/4 NE 1/4 Section Number 34 Township Number T 27 S Range Number R 16 E/W
 County: KIOWA

Distance and direction from nearest town or city street address of well if located within city?
3-N 3-E OF HAVILAND, KS.

2 WATER WELL OWNER: WOODMAN-~~IANNITTI~~ DRILLING CO.
 RR#, St. Address, Box #: P.O. BOX 308
 City, State, ZIP Code: GREAT BEND, KS. 67530
 Board of Agriculture, Division of Water Resources
 Application Number: T91-0041

3 LOCATE WELL'S LOCATION WITH AN "X" IN SECTION BOX:

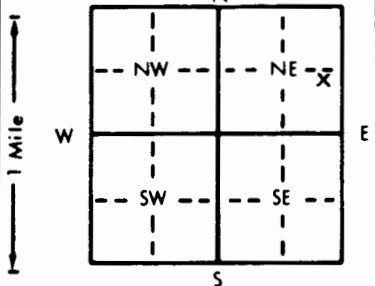

4 DEPTH OF COMPLETED WELL: 66 ft. ELEVATION: 66
 WELL WATER TO BE USED AS:
 5 Public water supply 8 Air conditioning 11 Injection well
 1 Domestic 3 Feedlot Oil field water supply 9 Dewatering 12 Other (Specify below)
 2 Irrigation 4 Industrial 7 Lawn and garden only 10 Monitoring well
 Was a chemical/bacteriological sample submitted to Department? Yes X No X; If yes, mo/day/yr sample was submitted
 Water Well Disinfected? Yes X No X

5 TYPE OF BLANK CASING USED:
 1 Steel 3 RMP (SR) 5 Wrought iron 8 Concrete tile CASING JOINTS: Glued X Clamped
 PVC 4 ABS 6 Asbestos-Cement 9 Other (specify below) Welded
 7 Fiberglass Threaded
 TYPE OF SCREEN OR PERFORATION MATERIAL:
 1 Steel 3 Stainless steel 5 Fiberglass PVC 10 Asbestos-cement
 2 Brass 4 Galvanized steel 6 Concrete tile 8 RMP (SR) 11 Other (specify)
 9 ABS 12 None used (open hole)
 SCREEN OR PERFORATION OPENINGS ARE:
 1 Continuous slot Mill slot 5 Gauzed wrapped 8 Saw cut 11 None (open hole)
 2 Louvered shutter 4 Key punched 6 Wire wrapped 9 Drilled holes
 7 Torch cut 10 Other (specify)

6 GROUT MATERIAL: 1 Neat cement 2 Cement grout Bentonite 4 Other
 What is the nearest source of possible contamination:
 1 Septic tank 4 Lateral lines 7 Pit privy 10 Livestock pens 14 Abandoned water well
 2 Sewer lines 5 Cess pool 8 Sewage lagoon 11 Fuel storage 15 Oil well/Gas well
 3 Watertight sewer lines 6 Seepage pit 9 Feedyard 12 Fertilizer storage 16 Other (specify below)
 13 Insecticide storage NONE
 Direction from well? NONE
 How many feet? NONE

FROM		TO		LITHOLOGIC LOG	FROM	TO	PLUGGING INTERVALS
0	3	0	3	TOP SOIL			
3	35	3	35	CLAY			
35	66	35	66	GRAVEL			

7 CONTRACTOR'S OR LANDOWNER'S CERTIFICATION: This water well was () constructed, (2) reconstructed, or (3) plugged under my jurisdiction and was completed on (mo/day/year) 2-3-91 and this record is true to the best of my knowledge and belief. Kansas Water Well Contractor's License No. 462-B. This Water Well Record was completed on (mo/day/yr) 3-8-91 under the business name of SAM'S WATER WELL SERVICE by (signature) *Sara Ruffen*

INSTRUCTIONS: Use typewriter or ball point pen. PLEASE PRESS FIRMLY and PRINT clearly. Please fill in blanks, underline or circle the correct answers. Send top three copies to Kansas Department of Health and Environment, Bureau of Water, Topeka, Kansas 66620-7320. Telephone: 913-296-5545. Send one to WATER WELL OWNER and retain one for your records.

OFFICE USE ONLY T R E/W SEC. 1/4 1/4 1/4