

USE TYPEWRITER OR BALL POINT PEN-PRESS FIRMLY, PRINT CLEARLY.

T R EW sec 1/4 1/4 1/4 No.

WATER WELL RECORD  
KSA 82a-1201-1215


Kansas State Dept. Of Health  
(Water Well Contractors)  
Forbes-Bldg. 740  
Topeka, Kansas 66620

1 Location of well:	County <b>Kiowa</b>	Township name	Fraction <b>SE 1/4</b>	Section number <b>35</b>	Town number <b>T-27</b>	Range number <b>R-16</b>
---------------------	------------------------	---------------	---------------------------	-----------------------------	----------------------------	-----------------------------

Distance and direction from nearest town or city: **2 mi North of Wellsford**

Street address of well location if in city: \_\_\_\_\_

3 Owner of well: **Glenn Clarkson**  
Address: **Haviland, Kansas**

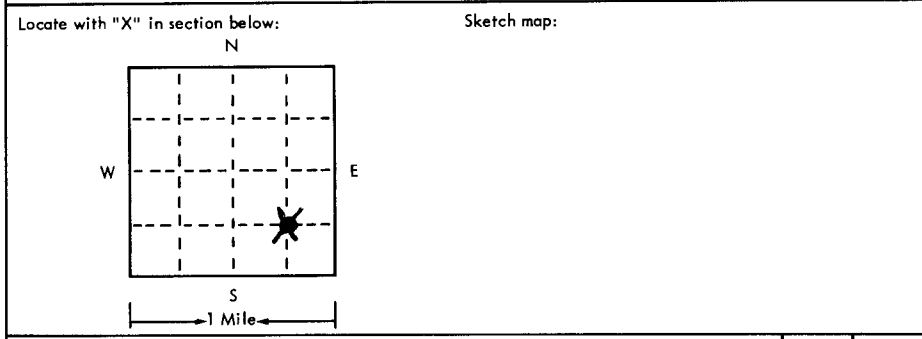

4 Well depth: **177** ft. Date of completion: **3/16/75**  
Well diameter **30** in.

5  Cable tool  Rotary  Driven  Dug  
 Hollow rod  Jetted  Bored  Reverse rotary

6 Use:  Domestic  Public supply  Industry  
 Irrigation  Air conditioning  Commercial  
 Test well  \_\_\_\_\_

7 Casing: Material **Stl** Height: above/below  
~~XXXXXX~~ Welded  Surface **12** in.  
Diam. \_\_\_\_\_ Weight **9.75** lbs./ft.  
**16** in. to **121** ft. depth Drive shoe?  Yes  No  
\_\_\_\_\_ in. to \_\_\_\_\_ ft. depth

2	Type and color of material	From	To
	Sandy top soil	0	2
	Sandy clay	2	6
	Clay	6	30
	Sand	30	36
	Clay	36	75
	Med. to coarse sand & gravel	75	111
	Clay	111	119
	Med. to coarse sand & gravel	119	150
	Caliche & clay - hard	150	165
	Fine sand	165	168
	Med. to coarse sand & gravel	168	176
	Clay	176	180
	(use a second sheet if needed)		

8 Screen:  
Manufacturer **Doerr**  
Type **Stl.** Dia. **16"**  
Slot/gauze **1/8** Length **56'**  
Set between **98** ft. and **177** ft.  
Fittings:  
Gravel pack  Yes  No Size range of material **3/16 x 3/8**

9 Static water level:  
**68.35** ft. below land surface Date **3/16/75**

10 Pumping level below land surfaces:  
**84.4** ft. after **4** hrs. pumping **1000** g.p.m.  
\_\_\_\_\_ ft. after \_\_\_\_\_ hrs. pumping \_\_\_\_\_ g.p.m.  
Estimated maximum yield **1000** g.p.m.

11 Water sample submitted:  
 Yes  No Date \_\_\_\_\_

12 Well head completion:  
 Pitless adapter  Inches above grade **12**

13 Well grouted?  Yes  No  
 Neat cement  Bentonite  **Clay**  
Depth: From **0** ft. to **15** ft.

14 Nearest source of possible contamination: **None Known**  
ft. \_\_\_\_\_ Direction \_\_\_\_\_ Type \_\_\_\_\_  
Well disinfected upon completion?  Yes  No

15 Pump:  Not installed  
Manufacturer's name **Layne**  
Model number **12KM** HP **80** Volts \_\_\_\_\_  
Length of drop pipe **100** ft. capacity **800** g.p.m.  
Type:  
 Submersible  Turbine  
 Jet  Reciprocating  
 Centrifugal  Other

16 Remarks: elevation

Topography:  
 Hill  
 Slope  
 Upland  
 Valley

17 Water well contractor's certification:  
This well was drilled under my jurisdiction and this report is true to the best of my knowledge and belief.  
**Layne Western Co. 102**  
Business name \_\_\_\_\_ License No. \_\_\_\_\_  
Address **Wichita, Kansas**  
Signed **[Signature]** Date **3/3/75**  
Authorized representative