


1 LOCATION OF WATER WELL: Fraction NE 1/4 NE 1/4 NW 1/4 Section Number 34 Township Number T 27 S Range Number R 16 EW

Distance and direction from nearest town or city street address of well if located within city?
 2.5 EAST 3 N FROM HAIRLAND

2 WATER WELL OWNER: LEVINE FRICKE
 RR#, St. Address, Box #: 401 WASHINGTON STREET Board of Agriculture, Division of Water Resources
 City, State, ZIP Code: ALGONQUIN, IL 60102 Application Number:

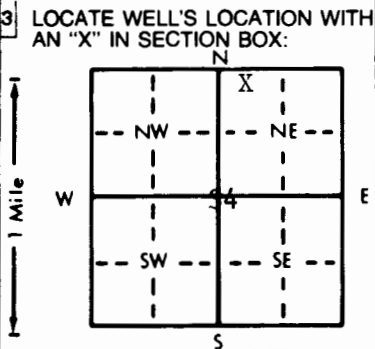

4 DEPTH OF COMPLETED WELL: 60 ft. ELEVATION:
 Depth(s) Groundwater Encountered 1. 52.5 ft. 2. ft. 3. ft.
 WELL'S STATIC WATER LEVEL: 52 ft. below land surface measured on mo/day/yr 2-14-95
 Pump test data: Well water was N/A ft. after hours pumping gpm
 Est. Yield: 2-5 gpm; Well water was ft. after hours pumping gpm
 Bore Hole Diameter: 8 in. to 60 ft., and in. to ft.
 WELL WATER TO BE USED AS:
 5 Public water supply 8 Air conditioning 11 Injection well
 1 Domestic 3 Feedlot 6 Oil field water supply 9 Dewatering 12 Other (Specify below)
 2 Irrigation 4 Industrial 7 Lawn and garden only 10 Monitoring well
 Was a chemical/bacteriological sample submitted to Department? Yes No X; If yes, mo/day/yr sample was submitted
 Water Well Disinfected? Yes No X

5 TYPE OF BLANK CASING USED:
 1 Steel 3 RMP (SR) 5 Wrought iron 8 Concrete tile CASING JOINTS: Glued Clamped
 2 PVC 4 ABS 6 Asbestos-Cement 9 Other (specify below) Welded
 7 Fiberglass Threaded
 Blank casing diameter: 2 in. to 50 ft., Dia. in. to ft., Dia. in. to ft.
 Casing height above land surface: 36 in., weight lbs./ft. Wall thickness or gauge No. SCHEDULE 40
 TYPE OF SCREEN OR PERFORATION MATERIAL:
 1 Steel 3 Stainless steel 5 Fiberglass 8 RMP (SR) 10 Asbestos-cement
 2 Brass 4 Galvanized steel 6 Concrete tile 9 ABS 11 Other (specify)
 12 None used (open hole)
 SCREEN OR PERFORATION OPENINGS ARE:
 1 Continuous slot 3 Mill slot 5 Gauzed wrapped 8 Saw cut 11 None (open hole)
 2 Louvered shutter 4 Key punched 6 Wire wrapped 9 Drilled holes
 7 Torch cut 10 Other (specify)
 SCREEN-PERFORATED INTERVALS: From 50 ft. to 60 ft., From ft. to ft.
 GRAVEL PACK INTERVALS: From 48 ft. to 60 ft., From ft. to ft.

6 GROUT MATERIAL: 1 Neat cement 2 Cement grout 3 Bentonite 4 Other
 Grout Intervals: From 0 ft. to 44.5 ft., From 44.5 ft. to 48 ft., From ft. to ft.
 What is the nearest source of possible contamination:
 1 Septic tank 4 Lateral lines 7 Pit privy 10 Livestock pens 14 Abandoned water well
 2 Sewer lines 5 Cess pool 8 Sewage lagoon 11 Fuel storage 15 Oil well/Gas well
 3 Watertight sewer lines 6 Seepage pit 9 Feedyard 12 Fertilizer storage 16 Other (specify below)
 13 Insecticide storage
 Direction from well? 1000' FEW DIRECTIONS How many feet?

FROM	TO	LITHOLOGIC LOG	FROM	TO	PLUGGING INTERVALS
0	10	BROWN SAND, CLAY, SAND, SILTY SAND			
10	29	BROWN CLAY, YELLOWISH BROWN SILTY CLAY			
29	36	BROWNISH YELLOW SILTY SAND			
36	45	YELLOWISH BROWN CLAY & SAND, CLAY			
45	60	PALE BROWN TO REDDISH YELLOW SAND			

7 CONTRACTOR'S OR LANDOWNER'S CERTIFICATION: This water well was (1) constructed, (2) reconstructed, or (3) plugged under my jurisdiction and was completed on (mo/day/year) 2/14/95 and this record is true to the best of my knowledge and belief. Kansas Water Well Contractor's License No. 438 This Water Well Record was completed on (mo/day/yr) 3/16/95 under the business name of Huntington Eng+Env by (signature) William J. Purdon

OFFICE USE ONLY
T
R
EW
SEC