


1 LOCATION OF WATER WELL: Fraction  $\frac{1}{4}$  N/C  $\frac{1}{4}$  NE  $\frac{1}{4}$  Section Number 20 Township Number T 27 S Range Number R 17 **NEW**

Distance and direction from nearest town or city street address of well if located within city?  
 4 1/2 east, 4 1/2 North of Greensburg, Ks.

2 WATER WELL OWNER: / Gary Taylor  
 RR#, St. Address, Box #: Rt. 1- Box 91 Board of Agriculture, Division of Water Resources  
 City, State, ZIP Code: Haviland, Ks. 67059 Application Number: 37982

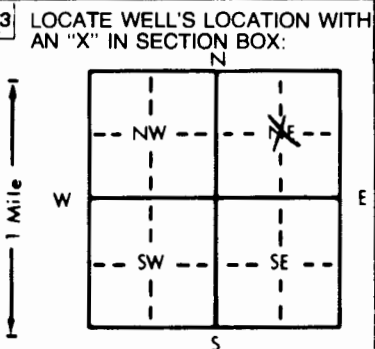

4 DEPTH OF COMPLETED WELL... 172 ft. ELEVATION: ...  
 Depth(s) Groundwater Encountered 1. ... ft. 2. ... ft. 3. ... ft.  
 WELL'S STATIC WATER LEVEL ... 51 ft. below land surface measured on mo/day/yr ... 11-10-95  
 Pump test data: Well water was ... ft. after ... hours pumping ... gpm  
 Est. Yield .1100. gpm: Well water was ... 62. ... ft. after ... 4. ... hours pumping 1000. ... gpm  
 Bore Hole Diameter ... 28. ... in. to ... 172. ... ft., and ... in. to ... ft.  
 WELL WATER TO BE USED AS: 5 Public water supply 8 Air conditioning 11 Injection well  
 1 Domestic 3 Feedlot 6 Oil field water supply 9 Dewatering 12 Other (Specify below)  
 2 Irrigation 4 Industrial 7 Lawn and garden only 10 Monitoring well  
 Was a chemical/bacteriological sample submitted to Department? Yes.....No..X.....; If yes, mo/day/yr sample was submitted  
 Water Well Disinfected? Yes No

5 TYPE OF BLANK CASING USED: 5 Wrought iron 8 Concrete tile CASING JOINTS: Glued .X. Clamped  
 1 Steel 3 RMP (SR) 6 Asbestos-Cement 9 Other (specify below) Welded  
 2 PVC 4 ABS 7 Fiberglass Threaded  
 Blank casing diameter ... 16. ... in. to ... 95. ... ft., Dia. ... 16. ... in. to ... 115. to 132, Dia. ... in. to ... ft.  
 Casing height above land surface ... 1. ... in., weight ... SDR 32.5 ... lbs./ft. Wall thickness or gauge No. ...  
 TYPE OF SCREEN OR PERFORATION MATERIAL: 7 PVC 10 Asbestos-cement  
 1 Steel 3 Stainless steel 5 Fiberglass 8 RMP (SR) 11 Other (specify)  
 2 Brass 4 Galvanized steel 6 Concrete tile 9 ABS 12 None used (open hole)  
 SCREEN OR PERFORATION OPENINGS ARE: 5 Gauzed wrapped 8 Saw cut 11 None (open hole)  
 1 Continuous slot 3 Mill slot 6 Wire wrapped 9 Drilled holes  
 2 Louvered shutter 4 Key punched 7 Torch cut 10 Other (specify)  
 SCREEN-PERFORATED INTERVALS: From ... 95. ... ft. to ... 115. ... ft., From ... 133. ... ft. to ... 172. ... ft.  
 From ... ft. to ... ft., From ... ft. to ... ft.  
 GRAVEL PACK INTERVALS: From ... 172. ... ft. to ... 20. ... ft., From ... ft. to ... ft.  
 From ... ft. to ... ft., From ... ft. to ... ft.

6 GROUT MATERIAL: 1 Neat cement 2 Cement grout 3 Bentonite 4 Other  
 Grout intervals: From ... 0. ... ft. to ... 20. ... ft., From ... ft. to ... ft., From ... ft. to ... ft.  
 What is the nearest source of possible contamination:  
 1 Septic tank 4 Lateral lines 7 Pit privy 10 Livestock pens 14 Abandoned water well  
 2 Sewer lines 5 Cess pool 8 Sewage lagoon 11 Fuel storage 15 Oil well/Gas well  
 3 Watertight sewer lines 6 Seepage pit 9 Feedyard 12 Fertilizer storage 16 Other (specify below)  
 13 Insecticide storage none

Direction from well? How many feet?

FROM	TO	LITHOLOGIC LOG	FROM	TO	PLUGGING INTERVALS
0	15	Sandy top soil			
15	25	Sandy gray clay			
25	35	Brown & white clay			
35	58	Sand and gravel clean, coarse, loose			
58	60	Brown clay			
60	88	Sand and gravel clean, coarse, loose			
88	90	Brown clay			
90	112	Sand and gravel clean, coarse, loose			
112	125	Brown & white clay			
125	130	Fine sand			
130	168	Sand and gravel clean, coarse, loose			
168	172	Blue gray, yellow brown fire clay			

7 CONTRACTOR'S OR LANDOWNER'S CERTIFICATION: This water well was (1) constructed, (2) reconstructed, or (3) plugged under my jurisdiction and was completed on (mo/day/year) ... 11-20-95 ... and this record is true to the best of my knowledge and belief. Kansas Water Well Contractor's License No. ... 134. ... This Water Well Record was completed on (mo/day/yr) ... 12-5-95 ... under the business name of Rosencrantz-Bemis by (signature) Fredia Rodson

OFFICE USE ONLY  
T  
R  
E  
M  
S  
E  
C  
1/4  
1/4  
1/4