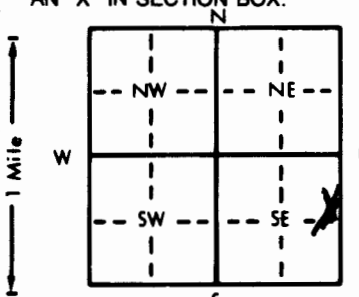


1 LOCATION OF WATER WELL: Fraction Section Number Township Number Range Number  
 County: Kiowa SE 1/4 NE 1/4 SE 1/4 10 T 27 S R 17 **EW**

Distance and direction from nearest town or city street address of well if located within city?  
7 1/2 south of Fellsburg, 3/4 east

2 WATER WELL OWNER: Glenn Mull  
 RR#, St. Address, Box # : Pawnee Rock, Ks. 67567 Board of Agriculture, Division of Water Resources  
 City, State, ZIP Code : Application Number: 39,822-39823

3 LOCATE WELL'S LOCATION WITH AN "X" IN SECTION BOX:  

 4 DEPTH OF COMPLETED WELL: 161 ft. ELEVATION: .....  
 Depth(s) Groundwater Encountered 1. .... ft. 2. .... ft. 3. .... ft.  
 WELL'S STATIC WATER LEVEL ... 44 ft. below land surface measured on mo/day/yr ... 6-26-90 ...  
 Pump test data: Well water was ..... ft. after ..... hours pumping ..... gpm  
 Est. Yield ... 1400 gpm: Well water was ... 55 ft. after ... 1 hours pumping ... 1250 gpm  
 Bore Hole Diameter ... 30 in. to ... 161 ft., and ... in. to ..... ft.  
 WELL WATER TO BE USED AS: 5 Public water supply 8 Air conditioning 11 Injection well  
 1 Domestic 3 Feedlot 6 Oil field water supply 9 Dewatering 12 Other (Specify below)  
2 Irrigation 4 Industrial 7 Lawn and garden only 10 Monitoring well .....  
 Was a chemical/bacteriological sample submitted to Department? Yes.....No. x.....; If yes, mo/day/yr sample was submitted  
 Water Well Disinfected? Yes hth No

5 TYPE OF BLANK CASING USED: 5 Wrought iron 8 Concrete tile CASING JOINTS: Glued X Clamped .....  
 1 Steel 3 RMP (SR) 6 Asbestos-Cement 9 Other (specify below) Welded .....  
 2 PVC 4 ABS 7 Fiberglass Threaded .....  
 Blank casing diameter ... 16 in. to ... 101 ft., Dia ..... in. to ..... ft., Dia ..... in. to ..... ft.  
 Casing height above land surface ... 12 in., weight ... SDR 32.5 lbs./ft. Wall thickness or gauge No. ....  
 TYPE OF SCREEN OR PERFORATION MATERIAL: 7 PVC 10 Asbestos-cement  
 1 Steel 3 Stainless steel 5 Fiberglass 8 RMP (SR) 11 Other (specify) .....  
 2 Brass 4 Galvanized steel 6 Concrete tile 9 ABS 12 None used (open hole)  
 SCREEN OR PERFORATION OPENINGS ARE: 5 Gauzed wrapped 8 Saw cut 11 None (open hole)  
 1 Continuous slot 3 Mill slot 6 Wire wrapped 9 Drilled holes  
 2 Louvered shutter 4 Key punched 7 Torch cut 10 Other (specify) .....  
 SCREEN-PERFORATED INTERVALS: From ... 101 ft. to ... 161 ft., From ..... ft. to ..... ft.  
 From ..... ft. to ..... ft., From ..... ft. to ..... ft.  
 GRAVEL PACK INTERVALS: From ... 20 ft. to ... 90 ft., From ... 92 ft. to ... 161 ft.  
 From ..... ft. to ..... ft., From ..... ft. to ..... ft.

6 GROUT MATERIAL: 1 Neat cement 2 Cement grout 3 Bentonite 4 Other hole plug 90 to 92  
 Grout Intervals: From ... 0 ft. to ... 20 ft., From ..... ft. to ..... ft., From ..... ft. to ..... ft.  
 What is the nearest source of possible contamination:  
 1 Septic tank 4 Lateral lines 7 Pit privy 10 Livestock pens 14 Abandoned water well  
 2 Sewer lines 5 Cess pool 8 Sewage lagoon 11 Fuel storage 15 Oil well/Gas well  
 3 Watertight sewer lines 6 Seepage pit 9 Feedyard 12 Fertilizer storage 16 Other (specify below)  
 13 Insecticide storage ..... none .....  
 Direction from well? How many feet?

FROM	TO	LITHOLOGIC LOG	FROM	TO	PLUGGING INTERVALS
0	6	Sandy top soil			
6	37	Brown clay			
37	89	Sand and gravel			
89	93	Clay			
93	109	Sand and gravel with clay stringers			
109	125	Clay			
125	161	Sand and gravel			

7 CONTRACTOR'S OR LANDOWNER'S CERTIFICATION: This water well was (1) constructed, (2) reconstructed, or (3) plugged under my jurisdiction and was completed on (mo/day/year) ... 12-6-90 ... and this record is true to the best of my knowledge and belief. Kansas Water Well Contractor's License No. ... 134 ... This Water Well Record was completed on (mo/day/yr) ... 1-14-91 ... under the business name of Rosencrantz-Bmeis by (signature) Freddie Hodson

OFFICE USE ONLY  
T  
R  
EW  
SEC.  
1/4  
1/4  
1/4