


1 LOCATION OF WATER WELL: Fraction Section Number Township Number Range Number  
 COUNTY: 049 KIOWA NE 1/4 NE 1/4 SE 1/4 15 T 27 S R 17 W

Distance and direction from nearest town or city street address of well if located within city?  
 5 1/2 N., 3 WEST OF HAVILAND, KANS.

2 WATER WELL OWNER: THOMPSON, JENNIE 052 Board of Agriculture, Division of Water Resources  
 RR#, St. Address, Box #: R.R.

City, State, ZIP code : HAVILAND, KS 67059- Application Number:

3 LOCATE WELL'S LOCATION WITH AN "X" IN SECTION BOX: 4 DEPTH OF COMPLETED WELL 100 ELEVATION:  
 Depth(s) Groundwater Encountered 1. 35 ft. 2. ft. 3. ft.

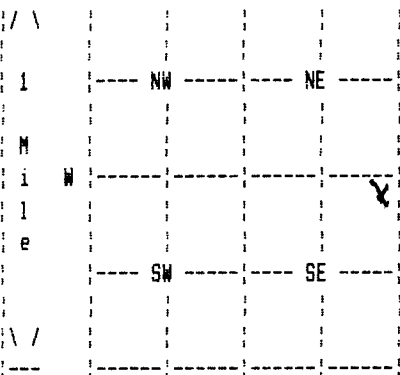

WELL'S STATIC WATER LEVEL 35 ft. below land surface measured on mo/day/yr 10/16/90  
 Pump test data: Well water was ft. after hours pumping gpm  
 Estimated Yield gpm: Well water was ft. after hours pumping gpm

Bore Hole Diameter 8.75 in. to 100 ft., and in. to ft.

WELL WATER TO BE USED AS: 01 DOMESTIC

Was a chemical/bacteriological sample submitted to department? No ;  
 If yes, mo/day/yr sample was submitted Water well disinfected? Yes

5 TYPE OF BLANK CASING USED: 02 PVC CASING JOINTS: GLUED  
 Blank casing diameter 5 in. to 80 ft., Dia in. to ft., Dia in. to ft.  
 Casing height above land surface 12 in., weight lbs/ft. Wall thickness or gauge No. 26  
 TYPE OF SCREEN OR PERFORATION MATERIAL: 07 PVC  
 SCREEN OR PERFORATION OPENINGS ARE: 08 SAW CUT

SCREEN PERFORATED INTERVALS: From 80 ft. to 100 ft., From ft. to ft.  
 From ft. to ft., From ft. to ft.  
 GRAVEL PACK INTERVALS: From 25 ft. to 100 ft., From ft. to ft.  
 From ft. to ft., From ft. to ft.

6 GROUT MATERIAL 03 BENTONITE  
 Grout intervals: From 4 ft. to 25 ft., From ft. to ft., From ft. to ft.  
 What is the nearest source of possible contamination: 01 SEPTIC TANK  
 Direction from well? S.W. How many feet? 90

FROM	TO	LITHOLOGIC LOG	FROM	TO	PLUGGING INTERVALS
	6	SILT & SAND			
6	26	TAN CLAY			
26	34	05 SAND 17 GRAVEL			
34	57	TAN CLAY			
57	100	05 SAND AND 17 GRAVEL			

7 CONTRACTOR'S OR LANDOWNER'S CERTIFICATION: This water well was Constructed under my jurisdiction and was completed on (mo/day/year) 10/16/90 and this record is true to the best of my knowledge and belief. Kansas Water Well Contractor's License No. 224 This Water Well Record was completed on (mo/day/yr) 07/06/91 under the business name of CARL HAYSE WATER WELL SVC by (signature) Carl Hayse