USE TYPEWRITER OR BALL POINT PEN-PRESS FIRMLY, PRINT CLEARLY.

WATER WELL RECORD
KSA 82a-1201-1215

Kansas Department of Health and Environment-Division of Environment
(Water well Contractors)
Topeka, Kansas 66620

1. Location of well:	County: Kiowa	Fraction: SW 1/4 SW 1/4 SW 1/4	Section number: 17	Township number: T 27 S	Range number: R 17 (E/W)

2. Distance and direction from nearest town or city: 6 N Greensburg
Street address of well location if in city: Kansas

3. Owner of well: Roland Seiler
R.R. or street: RR
City, state, zip code: Haviland Kansas

4. Locate with "X" in section below:

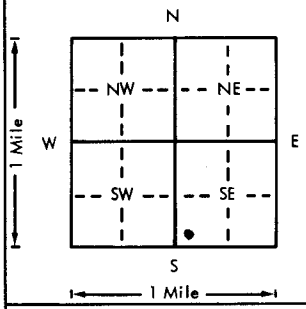

Sketch map:

5. Type and color of material	From	To
Top Soil	0	3
Sandy Clay Lite BR.	3	16
Clay Dk. Brown	16	18
Clay Lite Brown	18	21
Sand & Gravel	21	60

(Use a second sheet if needed)

6. Bore hole dia. 8 3/4 in. Completion date 3-11-77
Well depth 60 ft.

7. __ Cable tool X Rotary __ Driven __ Dug
__ Hollow rod __ Jetted __ Bored __ Reverse rotary

8. Use: X Domestic __ Public supply __ Industry
__ Irrigation __ Air conditioning __ Stock
__ Lawn __ Oil field water __ Other

9. Casing: Material PI
Threaded __ Welded GI
RMP X PVC __
Dia. 5 in. to 60 ft. depth
Dia. __ in. to __ ft. depth
Height: Above or below Surface 12 in.
Weight 1.5 lbs./ft.
Wall Thickness: inches or gage No. 200

10. Screen: Manufacturer's name SunFlower Plastics
Type RMP Dia. 5 in
Slot/gauze 18 Length 20
Set between 40 ft. and 60 ft.
__ ft. and __ ft.
Gravel pack? X Size range of material 1/8 X 3/4

11. Static water level: 29 ft. below land surface Date 3-11-77 mo./day/yr.

12. Pumping level below land surface: 29 ft. after 1 hrs. pumping 10 g.p.m.
__ ft. after __ hrs. pumping __ g.p.m.
Estimated maximum yield 25 g.p.m.

13. Water sample submitted: mo./day/yr.
__ Yes X No Date __

14. Well head completion:
X Pitless adapter 12 inches above grade

15. Well grouted? Yes
With: X Neat cement __ Bentonite __ Concrete
Depth: From 3 ft. to 13 ft.

16. Nearest source of possible contamination: ft. 100 Direction S Type Septic
Well disinfected upon completion? X Yes __ No

17. Pump: Not installed
Manufacturer's name Flint & Walling
Model number 7K412 HP 3/4 Volts 230
Length of drop pipe 50 ft. capacity 10 g.p.m.
Type:
X Submersible __ Turbine
__ Jet __ Reciprocating
__ Centrifugal __ Other

18. Elevation:
Topography:
__ Hill
__ Slope
X Upland
__ Valley

19. Remarks:

20. Water well contractor's certification:
This well was drilled under my jurisdiction and this report is true to the best of my knowledge and belief.
Carl Hayes Water Well Serv. 224
Business name License No.
6038 So. Maple Greensburg Ks
Address
Signed Carl Hayes Date 3-16-77
Authorized representative

27 17 W 17 Sec T R 1/4 1/4 1/4 1/4

Forward the white, blue and pink copies to the Department of Health and Environment

Form WWC-5

M1-1023