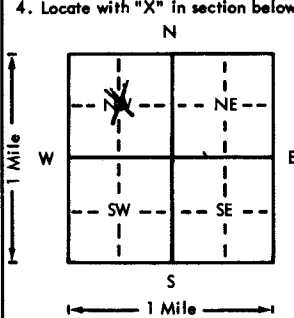


USE TYPEWRITER OR BALL POINT PEN-PRESS FIRMLY, PRINT CLEARLY.

WATER WELL RECORD  
KSA 82a-1201-1215

Kansas Department of Health and Environment-Division of Environment  
(Water well Contractors)  
Topeka, Kansas 66620

1. Location of well:		County <b>Kiowa</b>	Fraction <b>C NW</b> 1/4 1/4 1/4	Section number <b>18</b>	Township number <b>T 27 S</b>	Range number <b>R 17 E/W</b>
2. Distance and direction from nearest town or city: <b>6 1/2 mi NW of Bunkan, Ia</b> Street address of well location if in city:			3. Owner of well: <b>Ron Seiler</b> R.R. or street: City, state, zip code: <b>Greenburg, Ks</b>			
4. Locate with "X" in section below: 			Sketch map:			6. Bore hole dia. <b>2 1/2</b> in. Completion date <b>7-1-76</b> Well depth <b>134</b> ft.
5. Type and color of material			From	To	7. Cable tool <input checked="" type="checkbox"/> Rotary <input type="checkbox"/> Driven <input type="checkbox"/> Dug <input type="checkbox"/> Hollow rod <input type="checkbox"/> Jetted <input type="checkbox"/> Bored <input type="checkbox"/> Reverse rotary	
Sandy Top Soil			0	6	8. Use: <input type="checkbox"/> Domestic <input type="checkbox"/> Public supply <input type="checkbox"/> Industry <input checked="" type="checkbox"/> Irrigation <input type="checkbox"/> Air conditioning <input type="checkbox"/> Stock <input type="checkbox"/> Lawn <input type="checkbox"/> Oil field water <input type="checkbox"/> Other	
Brown Clay			6	27	9. Casing: Material <b>steel</b> Height: <b>Above surface</b> Threaded <input type="checkbox"/> Welded <input checked="" type="checkbox"/> Surface <b>18</b> in. RMP <input type="checkbox"/> PVC <input type="checkbox"/> Weight <input type="checkbox"/> lbs./ft. Dia. <b>16</b> in. to <b>134</b> ft. depth Wall Thickness: inches or Dia. <input type="checkbox"/> in. to <input type="checkbox"/> ft. depth gage No. <b>7</b>	
Sand and Gravel			27	115	10. Screen: Manufacturer's name <b>Doerns</b> Type <b>steel</b> Dia. <b>16</b> Slot <b>3/16</b> Length <b>60</b> Set between <b>74</b> ft. and <b>134</b> ft. Gravel pack? <input checked="" type="checkbox"/> Size range of material <b>1/2 3/4 3/8</b>	
Brown Clay			115	119	11. Static water level: <b>21</b> ft. below land surface Date <b>5-8-76</b> mo./day/yr.	
Sand and Gravel			119	134	12. Pumping level below land surfaces: <b>20</b> ft. after <b>1</b> hrs. pumping <b>1200</b> g.p.m. ____ ft. after ____ hrs. pumping ____ g.p.m. Estimated maximum yield <b>1400+</b> g.p.m.	
Hard Brown Clay			134	140	13. Water sample submitted: <input checked="" type="checkbox"/> Yes <input type="checkbox"/> No Date <b>5-8-76</b> mo./day/yr.	
					14. Well head completion: <input type="checkbox"/> Pitless adapter _____ Inches above grade	
					15. Well grouted? <input checked="" type="checkbox"/> With: <input type="checkbox"/> Neat cement <input type="checkbox"/> Bentonite <input checked="" type="checkbox"/> Concrete Depth: From <b>0</b> ft. to <b>10</b> ft.	
					16. Nearest source of possible contamination: ft. <b>1/4</b> Direction <b>W</b> Type <b>farmstead</b> Well disinfected upon completion? <input type="checkbox"/> Yes <input type="checkbox"/> No	
					17. Pump: <input type="checkbox"/> Not installed Manufacturer's name <b>Jacuzzi</b> Model number <b>4-12-MS</b> HP <b>80</b> Volts _____ Length of drop pipe <b>80</b> ft. capacity <b>800</b> g.p.m. Type: <input type="checkbox"/> Submersible <input checked="" type="checkbox"/> Turbine <input type="checkbox"/> Jet <input type="checkbox"/> Reciprocating <input type="checkbox"/> Centrifugal <input type="checkbox"/> Other	
18. Elevation:		19. Remarks:		20. Water well contractor's certification: This well was drilled under my jurisdiction and this report is true to the best of my knowledge and belief. <b>Rasencrantz-Demis 134</b> Business name _____ license No. _____ Address <b>Great Bend, Ks</b> Signed <b>Freddie Peterson</b> Date <b>9/11/76</b> Authorized representative		

22  
 120  
 18  
 C NW  
 1/4 1/4 1/4

Forward the white, blue and pink copies to the Department of Health and Environment

Form WWC-5