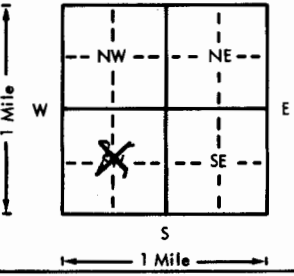
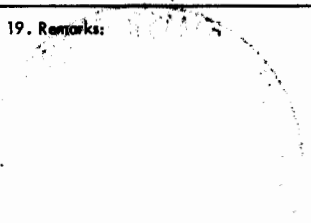


USE TYPEWRITER OR BALL POINT PEN-PRESS FIRMLY, PRINT CLEARLY.

WATER WELL RECORD  
KSA 82a-1201-1215

Kansas Department of Health and Environment-Division of Environment  
(Water well Contractors)  
Topeka, Kansas 66620

1. Location of well:		County <b>Kiowa</b>	Fraction <b>SW 1/4 1/4 1/4</b>	Section number <b>24</b>	Township number <b>T 27 S</b>	Range number <b>R 17 W</b>
2. Distance and direction from nearest town or city: <b>4 Miles North - 2 West of Haviland</b>			3. Owner of well: <b>Ronald Taylor Haviland, Kansas</b>			
4. Locate with "X" in section below: 			Sketch map: <b>Well No. 1 (TH 1-76)</b>		6. Bore hole dia. <b>30</b> in. Completion date Well depth <b>179</b> ft. <b>3/13/76</b>	
5. Type and color of material			From	To	7. <input type="checkbox"/> Cable tool <input type="checkbox"/> Rotary <input type="checkbox"/> Driven <input type="checkbox"/> Dug <input type="checkbox"/> Hollow rod <input type="checkbox"/> Jetted <input checked="" type="checkbox"/> Bored <input checked="" type="checkbox"/> Reverse rotary	
Sandy soil			0	3	8. Use: <input type="checkbox"/> Domestic <input type="checkbox"/> Public supply <input type="checkbox"/> Industry <input checked="" type="checkbox"/> Irrigation <input type="checkbox"/> Air conditioning <input type="checkbox"/> Stock <input type="checkbox"/> Lawn <input type="checkbox"/> Oil field water <input type="checkbox"/> Other	
Fine sand & clay			3	27	9. Casing: Material <b>Stl.</b> Height: Above or below Threaded <input type="checkbox"/> Welded <input checked="" type="checkbox"/> Surface <b>12</b> in. RMP <input type="checkbox"/> PVC <input type="checkbox"/> Weight <b>36.91</b> lbs./ft. Dia. <b>16</b> in. to <b>16.2</b> ft. depth Wall Thickness: inches or Dia. <input type="checkbox"/> in. to <input type="checkbox"/> ft. depth gage No. <b>219</b>	
Med. to coarse sand & clay			27	72	10. Screen: Manufacturer's name <b>Doerr</b> <b>Metal Products</b> Type <b>Stl.</b> Dia. <b>16"</b> Slot/gauze <b>1/8</b> Length <b>68'</b> Set between <input type="checkbox"/> ft. and <input type="checkbox"/> ft. Gravel pack? <input checked="" type="checkbox"/> Size range of material <b>1/2" to 1/2"</b>	
Clay			72	80	11. Static water level: <b>33</b> ft. below land surface Date <b>4/21/76</b>	
Med. to coarse sand & gravel			80	178	12. Pumping level below land surfaces: <b>45.15</b> ft. after <b>2</b> hrs. pumping <b>1000</b> g.p.m. <input type="checkbox"/> ft. after <input type="checkbox"/> hrs. pumping <input type="checkbox"/> g.p.m. Estimated maximum yield <b>2000</b> g.p.m.	
Gray & red shale			178	182	13. Water sample submitted: <input type="checkbox"/> Yes <input checked="" type="checkbox"/> No Date <input type="checkbox"/>	
					14. Well head completion: <input type="checkbox"/> Pitless adapter <b>12</b> inches above grade	
					15. Well grouted? <b>yes</b> With: <input type="checkbox"/> Neat cement <input type="checkbox"/> Bentonite <input checked="" type="checkbox"/> Concrete Depth: From <b>0</b> ft. to <b>10</b> ft.	
					16. Nearest source of possible contamination: ft. <b>2500</b> Direction <b>North</b> Type <b>Farm</b> Well disinfected upon completion? <input type="checkbox"/> Yes <input checked="" type="checkbox"/> No	
					17. Pump: <input type="checkbox"/> Not installed Manufacturer's name <b>Layne</b> Model number <b>12RH</b> HP <b>80</b> Volts <input type="checkbox"/> Length of drop pipe <b>80</b> ft. capacity <b>1000</b> g.p.m. Type: <input type="checkbox"/> Submersible <input checked="" type="checkbox"/> Turbine <input type="checkbox"/> Jet <input type="checkbox"/> Reciprocating <input type="checkbox"/> Centrifugal <input type="checkbox"/> Other	
					20. Water well contractor's certification: This well was drilled under my jurisdiction and this report is true to the best of my knowledge and belief. <b>Layne Western Co. 102</b> Business name License No. Address <b>Wichita Kansas</b> Signed <b>[Signature]</b> Date <b>4/29/76</b> Authorized representative	
18. Elevation:		19. Remarks: 				
Topography: <input type="checkbox"/> Hill <input checked="" type="checkbox"/> Slope <input type="checkbox"/> Upland <input type="checkbox"/> Valley						

T 27 S R 17 W  
 Sec 24

Forward the white, blue and pink copies to the Department of Health and Environment

Form WWC-5