

WATER WELL RECORD Form WNC-5 KSA 82a-1212


1 LOCATION OF WATER WELL: ; Fraction ; Section Number ; Township Number ; Range Number
 COUNTY: 049 KIOWA ; SE 1/4 NE 1/4 SE 1/4 ; 34 ; T 27 S ; R 18 W

Distance and direction from nearest town or city street address of well if located within city?
 1 E. 2 1/2 N. OF GREENSBURG, KS

2 WATER WELL OWNER: EUGENE EINSEL 324
 RR#, St. Address, Box #: RT. 1 Board of Agriculture, Division of Water Resources

City, State, ZIP code : GREENSBURG, KS 67054- Application Number:

3 LOCATE WELL'S LOCATION WITH AN "X" IN SECTION BOX: ; 4 DEPTH OF COMPLETED WELL 100 ELEVATION: 0
 Depth(s) Groundwater Encountered 1. 57 ft. 2. 0 ft. 3. 0 ft.

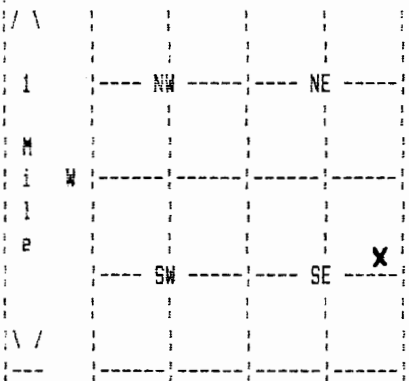

WELL'S STATIC WATER LEVEL 57 ft. below land surface measured on mo/day/yr
 Pump test data: Well water was 0 ft. after 0 hours pumping 0 gpm

Estimated Yield 0 gpm: Well water was 0 ft. after 0 hours pumping 0 gpm

Bore Hole Diameter 8.75 in. to 100 ft., and in. to 0 ft.

WELL WATER TO BE USED AS: 01 DOMESTIC

Was a chemical/bacteriological sample submitted to department? No ;
 If yes, mo/day/yr sample was submitted Water well disinfected? Yes

5 TYPE OF BLANK CASING USED: 02 PVC CASING JOINTS: GLUED
 Blank casing diameter 5 in. to 80 ft., Dia in. to 0 ft., Dia in. to 0 ft.
 Casing height above land surface 12 in., weight 0 lbs/ft. Wall thickness or gauge No. 26
 TYPE OF SCREEN OR PERFORATION MATERIAL: 07 PVC
 SCREEN OR PERFORATION OPENINGS ARE: 08 SAW CUT

SCREEN PERFORATED INTERVALS: From 80 ft. to 100 ft., From 0 ft. to 0 ft.
 From 0 ft. to 0 ft., From 0 ft. to 0 ft.
 GRAVEL PACK INTERVALS: From 25 ft. to 100 ft., From 0 ft. to 0 ft.
 From 0 ft. to 0 ft., From 0 ft. to 0 ft.

6 BROUT MATERIAL 03 BENTONITE
 Grout Intervals: From 1 ft. to 25 ft., From 0 ft. to 0 ft., From 0 ft. to 0 ft.

What is the nearest source of possible contamination: CATTLE PASTURE
 Direction from well? ALL How many feet? 6

FROM	TO	LITHOLOGIC LOG	FROM	TO	PLUGGING INTERVALS
0	45	TAN CLAY			
45	100	05 SAND AND 17 GRAVEL			

7 CONTRACTOR'S OR LANDOWNER'S CERTIFICATION: This water well was Constructed under my jurisdiction and was completed on (mo/day/year) 5-/31/95 and this record is true to the best of my knowledge and belief. Kansas Water Well Contractor's License No. 224 This Water Well Record was completed on (mo/day/yr) 06/17/95 under the business name of CARL HAYSE WATER WELL SVC by (signature) Carl Hayse