


WATER WELL RECORD Form WWC-5 KSA 82a-1212

1 LOCATION OF WATER WELL: Fraction Section Number Township Number Range Number
 COUNTY: 049 KIOWA SE 1/4 SE 1/4 NW 1/4 30 T 27 S R 18 W

Distance and direction from nearest town or city street address of well if located within city?
 4 N. 2 W. OF GREENSBURG, KS

2 WATER WELL OWNER: EUGNE EINSEL 333 Board of Agriculture, Division of Water Resources
 RR#, St. Address, Box #: R.R.
 City, State, ZIP code: GREENSBURG, KS 67054- Application Number:

3 LOCATE WELL'S LOCATION WITH AN "X" IN SECTION BOX:

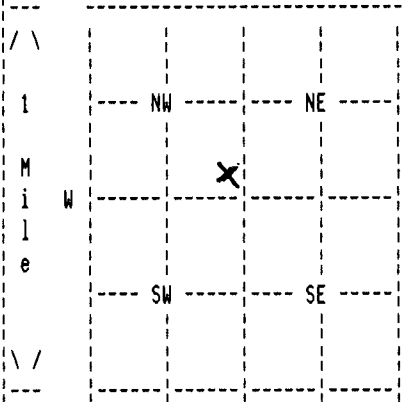

4 DEPTH OF COMPLETED WELL 98 ELEVATION: 0
 Depth(s) Groundwater Encountered 1. 51 ft. 2. 0 ft. 3. 0 ft.

WELL'S STATIC WATER LEVEL 51 ft. below land surface measured on mo/day/yr
 Pump testdata: Well water was 0 ft. after 0 hours pumping 0 gpm

Estimated Yield 0 gpm: Well water was 0 ft. after 0 hours pumping 0 gpm

Bore Hole Diameter 8.75 in. to 98 ft., and in. to 0 ft.

WELL WATER TO BE USED AS: 01 DOMESTIC

Was a chemical/bacteriological sample submitted to department? No ;
 If yes, mo/day/yr sample was submitted Water well disinfected? Yes

5 TYPE OF BLANK CASING USED: 02 PVC CASING JOINTS: GLUED
 Blank casing diameter 5 in. to 89 ft., Dia in. to 0 ft., Dia in. to 0 ft.
 Casing height above land surface 12 in., weight 0 lbs/ft. Wall thickness or gauge No. 26
 TYPE OF SCREEN OR PERFORATION MATERIAL: 07 PVC
 SCREEN OR PERFORATION OPENINGS ARE: 08 SAW CUT

SCREEN PERFORATED INTERVALS: From 88 ft. to 98 ft., From 0 ft. to 0 ft.
 From 0 ft. to 0 ft., From 0 ft. to 0 ft.
 GRAVEL PACK INTERVALS: From 25 ft. to 98 ft., From 0 ft. to 0 ft.
 From 0 ft. to 0 ft., From 0 ft. to 0 ft.

6 GROUT MATERIAL 03 BENTONITE
 Grout Intervals: From 1 ft. to 25 ft., From 0 ft. to 0 ft., From 0 ft. to 0 ft.
 What is the nearest source of possible contamination: CATTLE PASTURE
 Direction from well? ALL How many feet? 4

FROM	TO	LITHOLOGIC LOG	FROM	TO	PLUGGING INTERVALS
0	8	SILT & SAND			
8	38	TAN CLAY			
38	96	05 SAND AND 17 GRAVEL			
96	100	TAN CLAY			

7 CONTRACTOR'S OR LANDOWNER'S CERTIFICATION: This water well was Constructed under my jurisdiction and was completed on (mo/day/year) 8-3-95 and this record is true to the best of my knowledge and belief. Kansas Water Well Contractor's License No. 224 This Water Well Record was completed on (mo/day/yr) 09/16/95 under the business name of CARL HAYSE WATER WELL SVC by (signature) *Carl Hayse*