


WATER WELL RECORD Form WWC-5 KSA 82a-1212

1 LOCATION OF WATER WELL: Fraction Section Number Township Number Range Number
 COUNTY: KIOWA NE 1/4 NE 1/4 SE 1/4 6 T 27 S R 18 W

Distance and direction from nearest town or city street address of well if located within city?
 1 MILE WEST, 8 MILES NORTH OF GREENSBURG

2 WATER WELL OWNER: STOTTS, ROGER Board of Agriculture, Division of Water Resources
 RR#, St. Address, Box #: HWY 183
 City, State, ZIP code: GREENSBURG, KS 67054- Application Number:

3 LOCATE WELL'S LOCATION WITH AN "X" IN SECTION BOX:

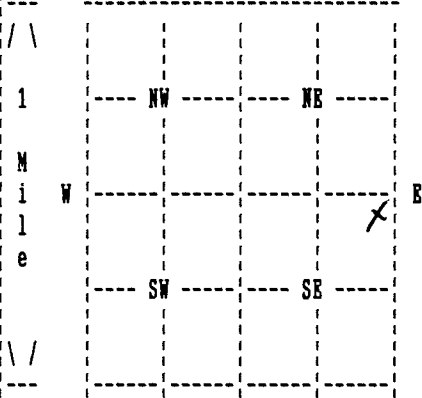

4 DEPTH OF COMPLETED WELL 100 ELEVATION: 0
 Depth(s) Groundwater Encountered 1. 52 ft. 2. 0 ft. 3. 0 ft.

WELL'S STATIC WATER LEVEL 52 ft. below land surface measured on mo/day/yr 08/05/01
 Pump testdata: Well water was 0 ft. after 0 hours pumping 0 gpm

Estimated Yield 0 gpm: Well water was 0 ft. after 0 hours pumping 0 gpm

Bore Hole Diameter 8.75 in. to 100 ft., and in. to 0 ft.

WELL WATER TO BE USED AS: DOMESTIC

Was a chemical/bacteriological sample submitted to department? No ;
 If yes, mo/day/yr sample was submitted Water well disinfected? Yes

5 TYPE OF BLANK CASING USED: PVC CASING JOINTS: GLUED
 Blank casing diameter 5 in. to 90 ft., Dia in. to 0 ft., Dia in. to 0 ft.
 Casing height above land surface 12 in., weight 0 lbs/ft. Wall thickness or gauge No. 26
 TYPE OF SCREEN OR PERFORATION MATERIAL: PVC
 SCREEN OR PERFORATION OPENINGS ARE: SAW CUT

SCREEN PERFORATED INTERVALS: From 90 ft. to 100 ft., From 0 ft. to 0 ft.
 From 0 ft. to 0 ft., From 0 ft. to 0 ft.
 GRAVEL PACK INTERVALS: From 23 ft. to 100 ft., From 0 ft. to 0 ft.
 From 0 ft. to 0 ft., From 0 ft. to 0 ft.

6 GROUT MATERIAL BENTONITE
 Grout Intervals: From 3 ft. to 23 ft., From 0 ft. to 0 ft., From 0 ft. to 0 ft.
 What is the nearest source of possible contamination: FUEL STORAGE
 Direction from well? WEST How many feet? 50

FROM	TO	LITHOLOGIC LOG	FROM	TO	PLUGGING INTERVALS
0	8	SILT SAND			
8	19	TAN CLAY			
19	32	SAND GRAVEL			
32	38	TAN CLAY			
38	71	SAND GRAVEL			
71	81	TAN CLAY			
81	100	SAND GRAVEL			

7 CONTRACTOR'S OR LANDOWNER'S CERTIFICATION: This water well was Constructed under my jurisdiction and was completed on (mo/day/year) and this record is true to the best of my knowledge and belief. Kansas Water Well Contractor's License No. 653 This Water Well Record was completed on (mo/day/yr) 11/08/01 under the business name of DAN HAYSE WATER WELL SVC. by (signature) Dan Hayse