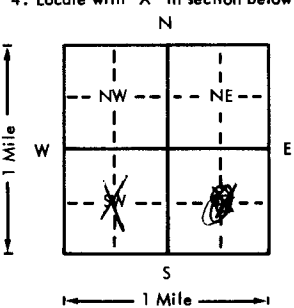


USE TYPEWRITER OR BALL POINT PEN-PRESS FIRMLY, PRINT CLEARLY.

WATER WELL RECORD  
KSA 82a-1201-1215

Kansas Department of Health and Environment-Division of Environment  
(Water well Contractors)  
Topeka, Kansas 66620

1. Location of well:		County <i>kiowa</i>	Fraction <i>C/SW</i> 1/4 1/4 1/4	Section number <i>4</i>	Township number <i>27</i> T 27 S R 18 E/W	Range number
2. Distance and direction from nearest town or city: <i>7 1/2 mi from Larned, KS</i> Street address of well location if in city: <i>1/2 W 1/4 S 1/4 W</i>			3. Owner of well: <i>Ron Ashworth</i> R.R. or street: <i>Rt. 2</i> City, state, zip code: <i>Larned, KS</i>			
4. Locate with "X" in section below: Sketch map: 			6. Bore hole dia. <i>2 1/2</i> in. Completion date <i>1-31-75</i> Well depth <i>172</i> ft.			
5. Type and color of material			From		To	
<i>Sandy Top Soil</i>			<i>0</i>		<i>2</i>	
<i>Sandy Brown Clay</i>			<i>2</i>		<i>6</i>	
<i>SAND &amp; Gravel Clay Mixed</i>			<i>6</i>		<i>16</i>	
<i>Brown &amp; Gray Clay</i>			<i>16</i>		<i>21</i>	
<i>Yellow Brown &amp; light Gray Clay</i>			<i>21</i>		<i>24</i>	
<i>Gray Clay</i>			<i>24</i>		<i>26</i>	
<i>Sandy &amp; Gray &amp; Brown Clay &amp; fine Sand</i>			<i>26</i>		<i>31</i>	
<i>SAND &amp; Gravel lot of Clay</i>			<i>31</i>		<i>36</i>	
<i>Medium Fine Sand &amp; Gravel</i>			<i>36</i>		<i>45</i>	
<i>Sand &amp; Gravel Clean Coarse loose</i>			<i>45</i>		<i>89</i>	
<i>Gray &amp; Brown Clay</i>			<i>89</i>		<i>97</i>	
<i>Sandy Yellow Brown &amp; light Gray</i>			<i>97</i>		<i>102</i>	
<i>Sand &amp; Gravel w/streaks of Clay</i>			<i>102</i>		<i>110</i>	
<i>Sand &amp; Gravel Clean Coarse loose</i>			<i>110</i>		<i>172</i>	
<i>Yellow Brown Clay</i>			<i>172</i>		<i>173</i>	
(Use a second sheet if needed)						
18. Elevation:		19. Remarks:				
Topography: <input checked="" type="checkbox"/> Hill <input type="checkbox"/> Slope <input type="checkbox"/> Upland <input type="checkbox"/> Valley						
20. Water well contractor's certification: This well was drilled under my jurisdiction and this report is true to the best of my knowledge and belief. <i>Rosencrantz - Bemis 134</i> Business name License No. Address <i>Larned, KS</i> Signed <i>Freda Jordan</i> Date <i>9/14/74</i> Authorized representative						

27  
 18  
 4  
 Sec  
 1/4  
 1/4  
 1/4  
 1/4

Forward the white, blue and pink copies to the Department of Health and Environment

Form WWC-5