


1 LOCATION OF WATER WELL: Fraction C 1/4 NE 1/4 NW 1/4 Section Number 8 Township Number T 27 S Range Number R 18W EW
 County: kiowa

Distance and direction from nearest town or city street address of well if located within city?
6 N, 1 1/2 W of Greensburg, Kansas

2 WATER WELL OWNER: Red Tiger Drilling Company
 RR#, St. Address, Box #: 1720 Kansas State Bank Bldg. Board of Agriculture, Division of Water Resources
 City, State, ZIP Code: Wichita, Kansas 67202 Application Number: T81-599

3 LOCATE WELL'S LOCATION WITH AN "X" IN SECTION BOX:

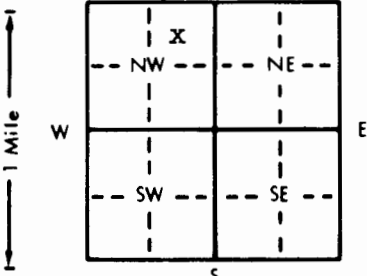

4 DEPTH OF COMPLETED WELL: 95 ft. ELEVATION: Unknown

Depth(s) Groundwater Encountered 1. 40 ft. 2. _____ ft. 3. _____ ft.
 WELL'S STATIC WATER LEVEL: 40 ft. below land surface measured on mo/day/yr 8/12/81

Pump test data: Well water was _____ ft. after _____ hours pumping _____ gpm
 Est. Yield 60 gpm: Well water was _____ ft. after _____ hours pumping _____ gpm
 Bore Hole Diameter: 8 in. to 95 ft., and _____ in. to _____ ft.

- WELL WATER TO BE USED AS:
- 5 Public water supply
 - 8 Air conditioning
 - 11 Injection well
 - 1 Domestic
 - 3 Feedlot
 - 6 Oil field water supply
 - 9 Dewatering
 - 12 Other (Specify below)
 - 2 Irrigation
 - 4 Industrial
 - 7 Lawn and garden only
 - 10 Observation well

Was a chemical/bacteriological sample submitted to Department? Yes _____ No _____; If yes, mo/day/yr sample was submitted _____
 Water Well Disinfected? Yes _____ No _____

5 TYPE OF BLANK CASING USED:

- 1 Steel
- 3 RMP (SR)
- 6 Asbestos-Cement
- 9 Other (specify below)
- 2 PVC
- 4 ABS
- 7 Fiberglass
- CASING JOINTS: Glued _____ Clamped _____
 Welded _____
 Threaded _____

Blank casing diameter: 5 in. to 75 ft., Dia _____ in. to _____ ft., Dia _____ in. to _____ ft.
 Casing height above land surface: 12 in., weight 2.8 lbs./ft. Wall thickness or gauge No. Sch. 40

TYPE OF SCREEN OR PERFORATION MATERIAL:

- 1 Steel
- 3 Stainless steel
- 5 Fiberglass
- 8 RMP (SR)
- 10 Asbestos-cement
- 2 Brass
- 4 Galvanized steel
- 6 Concrete tile
- 9 ABS
- 11 Other (specify) _____
- 12 None used (open hole)

SCREEN OR PERFORATION OPENINGS ARE:

- 5 Gauzed-wrapped
- 8 Saw cut
- 11 None (open hole)
- 1 Continuous slot
- 3 Mill slot
- 6 Wire wrapped
- 9 Drilled holes
- 2 Louvered shutter
- 4 Key punched
- 7 Torch cut
- 10 Other (specify) _____

SCREEN-PERFORATED INTERVALS: From 75 ft. to 95 ft., From _____ ft. to _____ ft.
 From _____ ft. to _____ ft., From _____ ft. to _____ ft.
 GRAVEL PACK INTERVALS: From 10 ft. to 95 ft., From _____ ft. to _____ ft.
 From _____ ft. to _____ ft., From _____ ft. to _____ ft.

6 GROUT MATERIAL: 1 Neat cement 2 Cement grout 3 Bentonite 4 Other _____
 Grout Intervals: From 0 ft. to 10 ft., From _____ ft. to _____ ft., From _____ ft. to _____ ft.

- What is the nearest source of possible contamination:
- 1 Septic tank
 - 4 Lateral lines
 - 7 Pit privy
 - 10 Livestock pens
 - 14 Abandoned water well
 - 2 Sewer lines
 - 5 Cess pool
 - 8 Sewage lagoon
 - 11 Fuel storage
 - 15 Oil well/Gas well
 - 3 Watertight sewer lines
 - 6 Seepage pit
 - 9 Feedyard
 - 12 Fertilizer storage
 - 16 Other (specify below)
 - 13 Insecticide storage

Direction from well? East How many feet? 60

FROM	TO	LITHOLOGIC LOG	FROM	TO	LITHOLOGIC LOG
0	20	Clay			
20	95	Sand and Gravel			

7 CONTRACTOR'S OR LANDOWNER'S CERTIFICATION: This water well was (1) constructed, (2) reconstructed, or (3) plugged under my jurisdiction and was completed on (mo/day/year) 8/12/81 and this record is true to the best of my knowledge and belief. Kansas Water Well Contractor's License No. 186. This Water Well Record was completed on (mo/day/yr) 9/15/81 under the business name of Kellys Water Wells by signature Kelly Price

INSTRUCTIONS: Use typewriter or ball point pen, PLEASE PRESS FIRMLY and PRINT clearly. Please fill in blanks, underline or circle the correct answers. Send top three copies to Kansas Department of Health and Environment, Division of Environment, Environmental Geology Section, Topeka, KS 66620. Send one to WATER WELL OWNER and retain one for your records.

OFFICE USE ONLY T 27 R 16 EW SEC. 8 C 85 ME 4 W 14