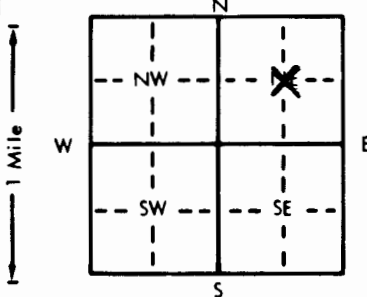


1 LOCATION OF WATER WELL: Fraction  $\frac{1}{4}$  C  $\frac{1}{4}$  NE  $\frac{1}{4}$  Section Number 9 Township Number T 27 S Range Number 18 EW  
 County: Kiowa

Distance and direction from nearest town or city street address of well if located within city?  
 7.4 North, 1/4 East from main street and 54 in Greensburg, Kansas

2 WATER WELL OWNER: Donald Unruh  
 RR#, St. Address, Box #: RFD Board of Agriculture, Division of Water Resources  
 City, State, ZIP Code: Greensburg, Kansas 67054 Application Number: 36,479

3 LOCATE WELL'S LOCATION WITH AN "X" IN SECTION BOX:  


4 DEPTH OF COMPLETED WELL: 125 ft. ELEVATION:  
 Depth(s) Groundwater Encountered 1. 58 ft. 2. ft. 3. ft.  
 WELL'S STATIC WATER LEVEL: 58 ft. below land surface measured on mo/day/yr 1 May 85  
 Pump test data: Well water was 67.6 ft. after 1 hours pumping 1000 gpm  
 Est. Yield gpm: Well water was 70.2 ft. after 1 hours pumping 1200 gpm  
 Bore Hole Diameter: 30 in. to 125 ft., and in. to ft.  
 WELL WATER TO BE USED AS:  
 5 Public water supply 8 Air conditioning 11 Injection well  
 1 Domestic 3 Feedlot 6 Oil field water supply 9 Dewatering 12 Other (Specify below)  
 2 Irrigation 4 Industrial 7 Lawn and garden only 10 Observation well  
 Was a chemical/bacteriological sample submitted to Department? Yes No X; If yes, mo/day/yr sample was submitted  
 Water Well Disinfected? Yes X No

5 TYPE OF BLANK CASING USED:  
 1 Steel 3 RMP (SR) 5 Wrought iron 8 Concrete tile CASING JOINTS: Glued Clamped  
 2 PVC 4 ABS 6 Asbestos-Cement 9 Other (specify below) Welded X  
 7 Fiberglass Threaded  
 Blank casing diameter 16 in. to 85 ft., Dia. in. to ft., Dia. in. to ft.  
 Casing height above land surface 12 in., weight 31.75 lbs./ft. Wall thickness or gauge No. 188  
 TYPE OF SCREEN OR PERFORATION MATERIAL:  
 1 Steel 3 Stainless steel 5 Fiberglass 8 RMP (SR) 10 Asbestos-cement  
 2 Brass 4 Galvanized steel 6 Concrete tile 9 ABS 11 Other (specify)  
 12 None used (open hole)  
 SCREEN OR PERFORATION OPENINGS ARE:  
 1 Continuous slot 3 Mill slot 5 Gauzed wrapped 8 Saw cut 11 None (open hole)  
 2 Louvered shutter 4 Key punched 6 Wire wrapped 9 Drilled holes  
 7 Torch cut 10 Other (specify)  
 SCREEN-PERFORATED INTERVALS: From 85 ft. to 125 ft., From ft. to ft.  
 From ft. to ft., From ft. to ft.  
 GRAVEL PACK INTERVALS: From 10 ft. to 125 ft., From ft. to ft.  
 From ft. to ft., From ft. to ft.

6 GROUT MATERIAL: 1 Neat cement 2 Cement grout 3 Bentonite 4 Other  
 Grout Intervals: From 0 ft. to 10 ft., From ft. to ft., From ft. to ft.  
 What is the nearest source of possible contamination:  
 1 Septic tank 4 Lateral lines 7 Pit privy 10 Livestock pens 14 Abandoned water well  
 2 Sewer lines 5 Cess pool 8 Sewage lagoon 11 Fuel storage 15 Oil well/Gas well  
 3 Watertight sewer lines 6 Seepage pit 9 Feedyard 12 Fertilizer storage 16 Other (specify below)  
 13 Insecticide storage None

Direction from well? How many feet?

FROM	TO	LITHOLOGIC LOG	FROM	TO	LITHOLOGIC LOG
0	2	Soil, sandy			
2	40	Sand, fine			
40	46	Clay, tan			
46	60	Sand, fine to coarse and fine to med gravel			
60	125	Sand, fine to coarse and fine to very coarse gravel, loose			

7 CONTRACTOR'S OR LANDOWNER'S CERTIFICATION: This water well was (1) constructed, (2) reconstructed, or (3) plugged under my jurisdiction and was completed on (mo/day/year) 13 May 85 and this record is true to the best of my knowledge and belief. Kansas Water Well Contractor's License No. 325 This Water Well Record was completed on (mo/day/yr) 4 June 85 under the business name of by signature: *D. Anonick*

INSTRUCTIONS: Use typewriter or ball point pen, PLEASE PRESS FIRMLY and PRINT clearly. Please fill in blanks, underline or circle the correct answers. Send top three copies to Kansas Department of Health and Environment, Division of Environment, Environmental Geology Section, Topeka, KS 66620. Send one to WATER WELL OWNER and retain one for your records.

OFFICE USE ONLY