


1 LOCATION OF WATER WELL: County: KLIOWA Fraction: NE 1/4 SE 1/4 NW 1/4 Section Number: 19 Township Number: T 27 S Range Number: R 18 EW

Distance and direction from nearest town or city street address of well, if located within city? 3 W 5 N Greensburg Kansas

2 WATER WELL OWNER: John Haney - ANNA GORALEXANDER - Clay Center, Neb.  
 RR#, St. Address, Box #: 422 N. Alexander Board of Agriculture, Division of Water Resources  
 City, State, ZIP Code: Greensburg Kans Application Number:

3 LOCATE WELL'S LOCATION WITH AN "X" IN SECTION BOX:

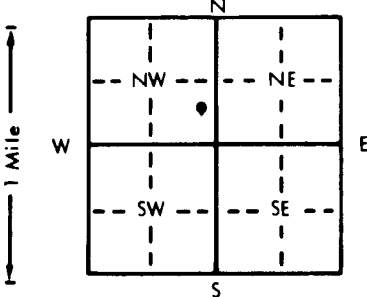

4 DEPTH OF COMPLETED WELL: 70 ft. ELEVATION:

Depth(s) Groundwater Encountered 1. 34 ft. 2. ft. 3. ft.

WELL'S STATIC WATER LEVEL 34 ft. below land surface measured on mo/day/yr 5-13-83

Pump test data: Well water was 34 ft. after 1 hours pumping 3 gpm

Est. Yield 20 gpm; Well water was ft. after hours pumping gpm

Bore Hole Diameter: 8 3/4 in. to 70 ft., and in. to ft.

WELL WATER TO BE USED AS: 5 Public water supply 8 Air conditioning 11 Injection well

1 Domestic 3 Feedlot 6 Oil field water supply 9 Dewatering 12 Other (Specify below)

2 Irrigation 4 Industrial 7 Lawn and garden only 10 Observation well

Was a chemical/bacteriological sample submitted to Department? Yes.....No..... If yes, mo/day/yr sample was submitted

Water Well Disinfected? Yes  No

5 TYPE OF BLANK CASING USED: 1 Steel  3 RMP (SR) 5 Wrought iron 8 Concrete tile CASING JOINTS: Glued  Clamped

Blank casing diameter 5 in. to 50 ft., Dia. in. to ft., Dia. in. to ft.

Casing height above land surface 1.8 in., weight lbs./ft. Wall thickness or gauge No. SDR-26

TYPE OF SCREEN OR PERFORATION MATERIAL: 1 Steel 3 Stainless steel 5 Fiberglass  8 RMP (SR) 10 Asbestos-cement

SCREEN OR PERFORATION OPENINGS ARE: 1 Continuous slot 3 Mill slot 5 Gauzed wrapped  8 Saw cut 11 None (open hole)

SCREEN-PERFORATED INTERVALS: From 50 ft. to 70 ft., From ft. to ft.

GRAVEL PACK INTERVALS: From 30 ft. to 70 ft., From ft. to ft.

6 GROUT MATERIAL:  1 Neat cement 2 Cement grout 3 Bentonite 4 Other

Grout Intervals: From 0 ft. to 10 ft., From ft. to ft., From ft. to ft.

What is the nearest source of possible contamination: 1 Septic tank 4 Lateral lines 7 Pit privy 10 Livestock pens 14 Abandoned water well

Direction from well? All Around How many feet? 4

FROM	TO	LITHOLOGIC LOG	FROM	TO	LITHOLOGIC LOG
0	2	Top Soil			
2	21	Sandy Clay			
21	27	BR. Clay			
27	70	Gravel			

7 CONTRACTOR'S OR LANDOWNER'S CERTIFICATION: This water well was  (1) constructed, (2) reconstructed, or (3) plugged under my jurisdiction and was completed on (mo/day/year) 5-13-83 and this record is true to the best of my knowledge and belief. Kansas

Water Well Contractor's License No. 224 This Water Well Record was completed on (mo/day/yr) 5-23-83  
 under the business name of Carl Kayse Water Well Serv. by (signature) Carl Kayse

INSTRUCTIONS: Use typewriter or ball point pen. PLEASE PRESS FIRMLY and PRINT clearly. Please fill in blanks, underline or circle the correct answers. Send top three copies to Kansas Department of Health and Environment, Division of Environment, Environmental Geology Section, Topeka, KS 66620. Send one to WATER WELL OWNER and retain one for your records.

OFFICE USE ONLY  
T  
37  
R  
18  
EW  
SEC. 19  
NE 1/4  
SE 1/4  
NW 1/4