


1 LOCATION OF WATER WELL: Fraction NE 1/4 SE 1/4 NE 1/4 Section Number 32 Township Number T 27 S Range Number R 18 EW
 County: kiowa

Distance and direction from nearest town or city street address of well, if located within city?
4A 1/2 W. Greensburg Kans

2 WATER WELL OWNER: Arthur Todd
 RR#, St. Address, Box #: Greensburg Kans
 City, State, ZIP Code: Greensburg Kans
 Board of Agriculture, Division of Water Resources
 Application Number:

3 LOCATE WELL'S LOCATION WITH AN "X" IN SECTION BOX:

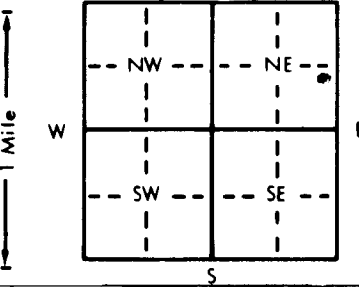

4 DEPTH OF COMPLETED WELL: 100 ft. ELEVATION:
 Depth(s) Groundwater Encountered 1. 49 ft. 2. 49 ft. 3. 49 ft.
 WELL'S STATIC WATER LEVEL: 49 ft. below land surface measured on 4-23-82 mo/day/yr
 Pump test data: Well water was 49 ft. after 1 hours pumping 10 gpm
 Est. Yield: 25 gpm; Well water was 49 ft. after 1 hours pumping 10 gpm
 Bore Hole Diameter: 8 3/4 in. to 100 ft., and 100 in. to 100 ft.
 WELL WATER TO BE USED AS:
 1 Domestic 3 Feedlot 6 Oil field water supply 9 Dewatering 12 Other (Specify below)
 2 Irrigation 4 Industrial 7 Lawn and garden only 10 Observation well
 Was a chemical/bacteriological sample submitted to Department? Yes No
 Water Well Disinfected? Yes No

5 TYPE OF BLANK CASING USED:
 1 Steel 3 RMP (SR) 5 Wrought iron 8 Concrete tile CASING JOINTS: Glued Clamped
 2 PVC 4 ABS 6 Asbestos-Cement 9 Other (specify below) Welded
 7 Fiberglass Threaded
 Blank casing diameter: 5 in. to 80 ft., Dia. 5 in. to 80 ft., Dia. 5 in. to 80 ft.
 Casing height above land surface: 12 in., weight 12 lbs./ft. Wall thickness or gauge No. SDR26

TYPE OF SCREEN OR PERFORATION MATERIAL:
 1 Steel 3 Stainless steel 5 Fiberglass 8 RMP (SR) 10 Asbestos-cement
 2 Brass 4 Galvanized steel 6 Concrete tile 9 ABS 11 Other (specify)
 12 None used (open hole)

SCREEN OR PERFORATION OPENINGS ARE:
 1 Continuous slot 3 Mill slot 5 Gauzed wrapped Saw cut 11 None (open hole)
 2 Louvered shutter 4 Key punched 6 Wire wrapped 9 Drilled holes
 7 Torch cut 10 Other (specify)

SCREEN-PERFORATED INTERVALS: From 80 ft. to 100 ft., From 80 ft. to 100 ft., From 80 ft. to 100 ft.
 GRAVEL PACK INTERVALS: From 65 ft. to 100 ft., From 65 ft. to 100 ft., From 65 ft. to 100 ft.

6 GROUT MATERIAL: 1 Neat cement 2 Cement grout 3 Bentonite 4 Other
 Grout Intervals: From 4 ft. to 15 ft., From 4 ft. to 15 ft., From 4 ft. to 15 ft.

What is the nearest source of possible contamination:
 1 Septic tank 4 Lateral lines 7 Pit privy 10 Livestock pens 14 Abandoned water well
 2 Sewer lines 5 Cess pool 8 Sewage lagoon 11 Fuel storage 15 Oil well/Gas well
 3 Watertight sewer lines 6 Seepage pit 9 Feedyard 12 Fertilizer storage 16 Other (specify below)
 13 Insecticide storage
 Direction from well? 50 NW
 How many feet? 50

FROM	TO	LITHOLOGIC LOG	FROM	TO	LITHOLOGIC LOG
0	20	TOP			
2	110	Silt + Sand			
11	390	Tan Clay			
39	64	Sand + Gravel			
64	67	Tan Clay			
67	81	Sand + Gravel			
81	84	Clay			
84	100	Gravel			

7 CONTRACTOR'S OR LANDOWNER'S CERTIFICATION: This water well was (1) constructed, (2) reconstructed, or (3) plugged under my jurisdiction and was completed on (mo/day/year) 4-23-82 and this record is true to the best of my knowledge and belief. Kansas Water Well Contractor's License No. 224 This Water Well Record was completed on (mo/day/yr) 4-21-83 under the business name of Carl Kayse Water Well Serv. by (signature) Carl Kayse
 INSTRUCTIONS: Use typewriter or ball point pen PLEASE PRESS FIRMLY and PRINT clearly. Please fill in blanks, underline or circle the correct answers. Send top three copies to Kansas Department of Health and Environment, Division of Environment, Environmental Geology Section, Topeka, KS 66620. Send one to WATER WELL OWNER and retain one for your records.

OFFICE USE ONLY
T 27 R 18 EW
SEC. 32 NE 1/4 SE 1/4 NE 1/4

D