


WATER WELL RECORD Form WWC-5 KSA 82a-1212

1 LOCATION OF WATER WELL: Fraction Section Number Township Number Range Number  
COUNTY: KIOWA SE 1/4 SE 1/4 SE 1/4 21 T 27 S R 18 W

Distance and direction from nearest town or city street address of well if located within city?  
4 MILES NORTH, 1/2 MILE EAST OF GREENSBURG

2 WATER WELL OWNER: BANTA, CLAIR  
RR#, St. Address, Box #: 302 E. IOWA Board of Agriculture, Division of Water Resources  
City, State, ZIP code: GREENSBURG, KS 67054- Application Number:

3 LOCATE WELL'S LOCATION WITH AN "X" IN SECTION BOX:

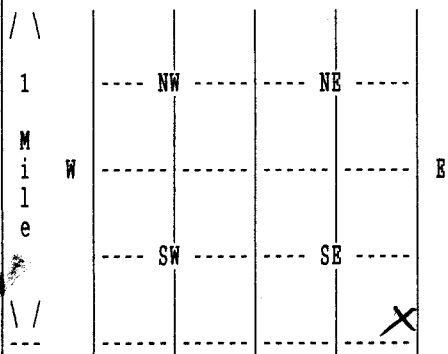

4 DEPTH OF COMPLETED WELL 110 ELEVATION: 0  
Depth(s) Groundwater Encountered 1. 0 ft. 2. 0 ft. 3. 0 ft.

WELL'S STATIC WATER LEVEL 44 ft. below land surface measured on mo/day/yr 03/18/05  
Pump test data: Well water was 0 ft. after 0 hours pumping 0 gpm

Estimated Yield 0 gpm: Well water was 0 ft. after 0 hours pumping 0 gpm

Bore Hole Diameter 8.75 in. to 110 ft., and in. to 0 ft.

WELL WATER TO BE USED AS: DOMESTIC

Was a chemical/bacteriological sample submitted to department? No ;  
If yes, mo/day/yr sample was submitted Water well disinfected? Yes

5 TYPE OF BLANK CASING USED: PVC CASING JOINTS: GLUED  
Blank casing diameter 5 in. to 100 ft., Dia in. to 0 ft., Dia in. to 0 ft.  
Casing height above land surface 12 in., weight 0 lbs/ft. Wall thickness or gauge No. 26  
TYPE OF SCREEN OR PERFORATION MATERIAL: PVC  
SCREEN OR PERFORATION OPENINGS ARE: SAW CUT

SCREEN PERFORATED INTERVALS: From 100 ft. to 110 ft., From 0 ft. to 0 ft.  
From 0 ft. to 0 ft., From 0 ft. to 0 ft.  
GRAVEL PACK INTERVALS: From 25 ft. to 110 ft., From 0 ft. to 0 ft.  
From 0 ft. to 0 ft., From 0 ft. to 0 ft.

6 GROUT MATERIAL BENTONITE  
Grout Intervals: From 4 ft. to 25 ft., From 0 ft. to 0 ft., From 0 ft. to 0 ft.  
What is the nearest source of possible contamination: SEPTIC TANK  
Direction from well? NORTH How many feet? 100

FROM	TO	LITHOLOGIC LOG	FROM	TO	PLUGGING INTERVALS
0	8	SILT AND SAND			
8	28	TAN CLAY			
28	34	SAND AND GRAVEL			
34	38	TAN CLAY			
38	65	SAND AND GRAVEL			
65	67	TAN CLAY			
67	110	SAND AND GRAVEL			

7 CONTRACTOR'S OR LANDOWNER'S CERTIFICATION: This water well was Constructed under my jurisdiction and was completed on (mo/day/year) 03/18/05 and this record is true to the best of my knowledge and belief. Kansas  
Water Well Contractor's License No. 653 This Water Well Record was completed on (mo/day/yr) 04/01/05  
under the business name of DAN HAYSE WATER WELL SERV by (signature) Dan Hayse