



COPY

P.O. BOX 1006
PRATT, KANSAS 67124
(620) 672-9508 Phone/(620) 672-9509 Fax

WATER WELL ACCEPTANCE AGREEMENT

Water Well Name: Nauman #1-32

Water Well Location: Section 32 Township 27s 11w 18w
County Kiowa

Water Well Location (footage): 630' FSL & 830' FEL Section 32

Board of Agriculture, Division of Water Resources Application Number: 20110289

Central Kansas Local Environmental Planning Group Permit Number: NA

This agreement between Sterling Drilling Company, P.O. Box 1006, Pratt, Kansas, 67124, and

Carl Nauman
20267 25th Avenue
Greensburg, KS 67054

certifies that they accept the above listed water well that was drilled by Kelly's Water Well Service, Inc.,
Great Bend, Kansas, located approximately 630' FSL & 830' FEL
of Section 32 Township 27s Range 18w Kiowa County,
Kansas for domestic use only and when the well is no longer needed agrees to plug the well in
accordance with the State Regulation KAR 28-30-7.

By signing this agreement, landowner releases Sterling Drilling Company from any
further responsibilities relating to the water well described above. And agrees to allow Sterling
Drilling and/or Strata use of this water well free of charge for any future drilling
operations within 1/2 mile of this water well. Sterling Drilling and or Strata would be
responsible for the filing and payment of any required county and state permits required for use of the
water at that time.

1/27/2012
Date

Gary M. Talbott
Gary M. Talbott, Operations Manager
Sterling Drilling Company

1-30-12
Date

Carl Nauman
Carl Nauman
Landowner

Copy of the WWC-5 permit attached

RECEIVED
APR 17 2012
BUREAU OF WATER
WATER RESOURCES
RECEIVED
APR 13 2012
KS DEPT OF AGRICULTURE

SCANNED

WATER WELL RECORD

Form WWC-5

Division of Water Resources App. No.


20110289

1 LOCATION OF WATER WELL: County: <u>Kiowa</u>	Fraction <u>¼ NW ¼ SE ¼ SE ¼</u>	Section Number <u>32</u>	Township No. <u>T 27 S</u>	Range Number <u>R 18</u> <input type="checkbox"/> E <input checked="" type="checkbox"/> W
--	-------------------------------------	-----------------------------	-------------------------------	--

Street/Rural Address of Well Location; if unknown, distance & direction from nearest town or intersection: If at owner's address, check here .
2N, 1/2E Greensburg, KS

Global Positioning System (GPS) information:
 Latitude: (in decimal degrees)
 Longitude: (in decimal degrees)
 Elevation:
 Datum: WGS 84, NAD 83, NAD 27
 Collection Method:
 GPS unit (Make/Model:)
 Digital Map/Photo, Topographic Map, Land Survey
 Est. Accuracy: <3 m, 3-5 m, 5-15 m, >15 m

2 WATER WELL OWNER: Carl Naumann
 RR#, Street Address, Box #: 20267 25th Ave.
 City, State, ZIP Code : Greensburg, KS 67054

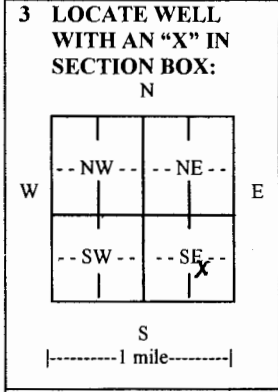

4 DEPTH OF COMPLETED WELL 111 ft.
 Depth(s) Groundwater Encountered (1) 60 ft. (2) ft. (3) ft.
 WELL'S STATIC WATER LEVEL 60 ft. below land surface measured on mo/day/yr. 08/19/11
 Pump test data: Well water was ft. after hours pumping gpm
 EST. YIELD 80 gpm. Well water was ft. after hours pumping gpm
 Bore Hole Diameter in. to ft., and in. to ft.
 WELL WATER TO BE USED AS: Public water supply Geothermal Injection well
 Domestic Feedlot Oil field water supply Dewatering Other (Specify below)
 Irrigation Industrial Domestic-lawn & garden Monitoring well
 Was a chemical/bacteriological sample submitted to Department? Yes No
 If yes, mo/day/yr sample was submitted.....
 Water well disinfected? Yes No

5 TYPE OF CASING USED: Steel PVC Other
 CASING JOINTS: Glued Clamped Welded Threaded
 Casing diameter 5 in. to 91 ft., Diameter in. to ft., Diameter in. to ft.
 Casing height above land surface 12 in., Weight 2.8 lbs./ft., Wall thickness or gauge No. Sch 40
 TYPE OF SCREEN OR PERFORATION MATERIAL:
 Steel Stainless Steel PVC Other (Specify)
 Brass Galvanized Steel None used (open hole)
 SCREEN OR PERFORATION OPENINGS ARE:
 Continuous slot Mill slot Gauze wrapped Torch cut Drilled holes None (open hole)
 Louvered shutter Key punched Wire wrapped Saw cut Other (specify)
 SCREEN-PERFORATED INTERVALS: From 91 ft. to 111 ft., From ft. to ft.
 From ft. to ft., From ft. to ft.
 GRAVEL PACK INTERVALS: From 20 ft. to 111 ft., From ft. to ft.
 From ft. to ft., From ft. to ft.

6 GROUT MATERIAL: Neat cement Cement grout Bentonite Other
 Grout Intervals: From 0 ft. to 23 ft., From ft. to ft., From ft. to ft.
 What is the nearest source of possible contamination:
 Septic tank Lateral lines Pit privy Livestock pens Insecticide storage Other (specify below)
 Sewer lines Cesspool Sewage lagoon Fuel storage Abandoned water well
 Watertight sewer lines Seepage pit Feedyard Fertilizer storage Oil well/gas well
 Direction from well South Distance from well 120

FROM	TO	LITHOLOGIC LOG	FROM	TO	LITHO. LOG (cont.) or PLUGGING INTERVALS
0	6	top sand			
6	50	clay			
50	110	sand and gravel			
110	111	clay			

7 CONTRACTOR'S OR LANDOWNER'S CERTIFICATION: This water well was constructed, reconstructed, or plugged under my jurisdiction and was completed on (mo/day/year) 08/19/11 and this record is true to the best of my knowledge and belief.
 Kansas Water Well Contractor's License No. 186 This Water Well Record was completed on (mo/day/year) 08/23/11
 under the business name of Kelly's Water Well Service, Inc. by (signature) Kathryn K. Brad

INSTRUCTIONS: Use typewriter or ball point pen. PLEASE PRESS FIRMLY and PRINT clearly. Please fill in blanks and check the correct answers. Send three copies (white, blue, pink) to Kansas Department of Health and Environment, Bureau of Water, Geology Section, 1000 SW Jackson St., Suite 420, Topeka, Kansas 66612-1367. Telephone 785-296-5522. Send one copy to WATER WELL OWNER and retain one for your records. Include fee of \$5.00 for each constructed well. Visit us at <http://www.kdheks.gov/waterwell/index.html>.