

WATER WELL RECORD

Form WWC-5

Division of Water Resources App. No.


20120143

1 LOCATION OF WATER WELL: County: Kiowa, Fraction 1/4 SW 1/4 NW 1/4 NE 1/4, Section Number 33, Township No. T 27 S, Range Number R 18, E W

Street/Rural Address of Well Location; if unknown, distance & direction from nearest town or intersection: If at owner's address, check here [] 3N of Greensburg, KS

2 WATER WELL OWNER: Jerry Robertson, RR#, Street Address, Box #: 3545 South Holmes, City, State, ZIP Code : Salina, KS 67401

Global Positioning System (GPS) information: Latitude: (in decimal degrees), Longitude: (in decimal degrees), Elevation: Datum: [] WGS 84, [] NAD 83, [] NAD 27, Collection Method: [] GPS unit, [] Digital Map/Photo, [] Topographic Map, [] Land Survey, Est. Accuracy: [] <3 m, [] 3-5 m, [] 5-15 m, [] >15 m

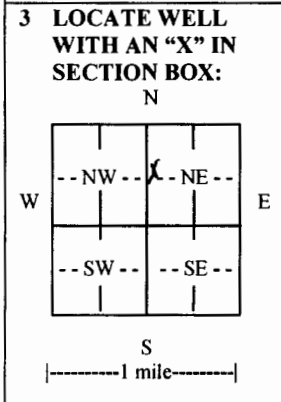

3 LOCATE WELL WITH AN "X" IN SECTION BOX: 4 DEPTH OF COMPLETED WELL 124 ft. Depth(s) Groundwater Encountered (1).60 ft. (2) ft. (3) ft. WELL'S STATIC WATER LEVEL .60 ft. below land surface measured on mo/day/yr. 2-28-12. Pump test data: Well water was ft. after hours pumping gpm EST. YIELD .80 gpm. Well water was ft. after hours pumping gpm Bore Hole Diameter in. to ft., and in. to ft. WELL WATER TO BE USED AS: [] Public water supply, [] Geothermal, [] Injection well, [] Domestic, [] Feedlot, [x] Oil field water supply, [] Dewatering, [] Other (Specify below), [] Irrigation, [] Industrial, [] Domestic-lawn & garden, [] Monitoring well. Was a chemical/bacteriological sample submitted to Department? [] Yes [x] No. If yes, mo/day/yr sample was submitted. Water well disinfected? [x] Yes [] No

5 TYPE OF CASING USED: [] Steel [x] PVC [] Other. CASING JOINTS: [x] Glued [] Clamped [] Welded [] Threaded. Casing diameter .5 in. to 104 ft., Diameter in. to ft., Diameter in. to ft. Casing height above land surface 12 in., Weight 2.8 lbs./ft., Wall thickness or gauge No. Sch. 40. TYPE OF SCREEN OR PERFORATION MATERIAL: [] Steel, [] Stainless Steel, [x] PVC, [] Other (Specify). SCREEN OR PERFORATION OPENINGS ARE: [] Continuous slot, [] Mill slot, [] Gauze wrapped, [] Torch cut, [] Drilled holes, [] None (open hole), [] Louvered shutter, [] Key punched, [] Wire wrapped, [x] Saw cut, [] Other (specify). SCREEN-PERFORATED INTERVALS: From 104 ft. to 124 ft., From ft. to ft., From ft. to ft. GRAVEL PACK INTERVALS: From 20 ft. to 124 ft., From ft. to ft., From ft. to ft.

6 GROUT MATERIAL: [] Neat cement, [] Cement grout, [x] Bentonite, [] Other. Grout Intervals: From 0 ft. to 20 ft., From ft. to ft., From ft. to ft. What is the nearest source of possible contamination: [] Septic tank, [] Lateral lines, [] Pit privy, [] Livestock pens, [] Insecticide storage, [] Other (specify below), [] Sewer lines, [] Cesspool, [] Sewage lagoon, [] Fuel storage, [] Abandoned water well, [] Watertight sewer lines, [] Seepage pit, [] Feedyard, [] Fertilizer storage, [x] Oil well/gas well. Direction from well East, Distance from well 120.

Table with columns: FROM, TO, LITHOLOGIC LOG, FROM, TO, LITHO. LOG (cont.) or PLUGGING INTERVALS. Rows: 0-2 top sand, 2-15 sandy clay, 15-30 clay, 30-124 sand and gravel. Includes Sterling Drilling Company, P O Box 1006, Pratt, KS 67124.

7 CONTRACTOR'S OR LANDOWNER'S CERTIFICATION: This water well was [x] constructed, [] reconstructed, or [] plugged under my jurisdiction and was completed on (mo/day/year) 02/28/12 and this record is true to the best of my knowledge and belief. Kansas Water Well Contractor's License No. 186. This Water Well Record was completed on (mo/day/year) 02/29/12 under the business name of Kelly's Water Well Service, Inc. by (signature) Kathryn L. Good

INSTRUCTIONS: Use typewriter or ball point pen. PLEASE PRESS FIRMLY and PRINT clearly. Please fill in blanks and check the correct answers. Send three copies (white, blue, pink) to Kansas Department of Health and Environment, Bureau of Water, Geology Section, 1000 SW Jackson St., Suite 420, Topeka, Kansas 66612-1367. Telephone 785-296-5524. Send one copy to WATER WELL OWNER and retain one for your records. Include fee of \$5.00 for each constructed well. Visit us at http://www.kdheks.gov/waterwell/index.html.