

WATER WELL RECORD

Form WWC-5

Division of Water Resources App. No.


20121036

1 LOCATION OF WATER WELL: County: Kiowa	Fraction ¼ NW ¼ SE ¼ NE ¼	Section Number 10	Township No. T 27 S	Range Number R 18 <input type="checkbox"/> E <input checked="" type="checkbox"/> W
--	-------------------------------------	-----------------------------	-------------------------------	--

Street/Rural Address of Well Location; if unknown, distance & direction from nearest town or intersection: If at owner's address, check here .
1/2E, 6 1/2N of Greensburg, KS

Global Positioning System (GPS) information:
 Latitude: (in decimal degrees)
 Longitude: (in decimal degrees)
 Elevation:
 Datum: WGS 84, NAD 83, NAD 27
 Collection Method:
 GPS unit (Make/Model:)
 Digital Map/Photo, Topographic Map, Land Survey
 Est. Accuracy: <3 m, 3-5 m, 5-15 m, >15 m

2 WATER WELL OWNER: **Clayton Hamblin**
 RR#, Street Address, Box #: **1953 Jackson St.**
 City, State, ZIP Code : **Lewis, KS 67552**

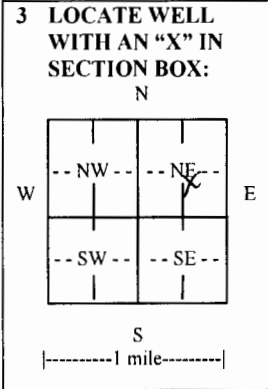

4 DEPTH OF COMPLETED WELL **105** ft.
 Depth(s) Groundwater Encountered (1) **50** ft. (2) ft. (3) ft.
 WELL'S STATIC WATER LEVEL **50** ft. below land surface measured on mo/day/yr. **12/21/12**
 Pump test data: Well water was ft. after hours pumping gpm
 EST. YIELD **80** gpm. Well water was ft. after hours pumping gpm
 Bore Hole Diameter in. to ft., and in. to ft.
 WELL WATER TO BE USED AS: Public water supply Geothermal Injection well
 Domestic Feedlot Oil field water supply Dewatering Other (Specify below)
 Irrigation Industrial Domestic-lawn & garden Monitoring well
 Was a chemical/bacteriological sample submitted to Department? Yes No
 If yes, mo/day/yr sample was submitted
 Water well disinfected? Yes No

5 TYPE OF CASING USED: Steel PVC Other
 CASING JOINTS: Glued Clamped Welded Threaded
 Casing diameter **5** in. to **85** ft., Diameter in. to ft., Diameter in. to ft.
 Casing height above land surface **12** in., Weight **2.8** lbs./ft., Wall thickness or gauge No. **Sch 40**
 TYPE OF SCREEN OR PERFORATION MATERIAL:
 Steel Stainless Steel PVC Other (Specify)
 Brass Galvanized Steel None used (open hole)
 SCREEN OR PERFORATION OPENINGS ARE:
 Continuous slot Mill slot Gauze wrapped Torch cut Drilled holes None (open hole)
 Louvered shutter Key punched Wire wrapped Saw cut Other (specify)
 SCREEN-PERFORATED INTERVALS: From **85** ft. to **105** ft., From ft. to ft.
 From ft. to ft., From ft. to ft.
 GRAVEL PACK INTERVALS: From **23** ft. to **105** ft., From ft. to ft.
 From ft. to ft., From ft. to ft.

6 GROUT MATERIAL: Neat cement Cement grout Bentonite Other
 Grout Intervals: From **0** ft. to **23** ft., From ft. to ft., From ft. to ft.
 What is the nearest source of possible contamination:
 Septic tank Lateral lines Pit privy Livestock pens Insecticide storage Other (specify below)
 Sewer lines Cesspool Sewage lagoon Fuel storage Abandoned water well
 Watertight sewer lines Seepage pit Feedyard Fertilizer storage Oil well/gas well
 Direction from well **East Southeast** Distance from well **120**

FROM	TO	LITHOLOGIC LOG	FROM	TO	LITHO. LOG (cont.) or PLUGGING INTERVALS
0	7	top sand			
7	50	clay			Hamblin Trust 1-10
50	105	sand and gravel shale bottom			
					Sterling Drilling Company
					P O Box 1006
					Pratt, KS 67124

7 CONTRACTOR'S OR LANDOWNER'S CERTIFICATION: This water well was constructed, reconstructed, or plugged under my jurisdiction and was completed on (mo/day/year) **12/21/12** and this record is true to the best of my knowledge and belief. Kansas Water Well Contractor's License No. **186** This Water Well Record was completed on (mo/day/year) **12/31/12** under the business name of **Kelly's Water Well Service, Inc.** by (signature) *Kathryn A. Brad*

INSTRUCTIONS: Use typewriter or ball point pen. **PLEASE PRESS FIRMLY** and **PRINT** clearly. Please fill in blanks and check the correct answers. Send three copies (white, blue, pink) to Kansas Department of Health and Environment, Bureau of Water, Geology Section, 1000 SW Jackson St., Suite 420, Topeka, Kansas 66612-1367. Telephone 785-296-5524. Send one copy to WATER WELL OWNER and retain one for your records. Include fee of \$5.00 for each constructed well. Visit us at <http://www.kdheks.gov/waterwell/index.html>.

STERLING DRILLING COMPANY

P.O. Box 1006
Pratt, Kansas 67124-1006
Phone (620) 672-9508
Federal ID #: 48-1185919

WATER WELL ACCEPTANCE AGREEMENT

Water Well Name: Hamblin
Water Well Location: Section 10 Township 27s Range 18w
County Kiowa
Water Well Location (footage): 3400' FSL & 690 FEL Section 10
Board of Agriculture, Division of Water Resources Application Number: 2012036

This agreement between Sterling Drilling Company, P.O. Box 1006, Pratt, Kansas, 67124, and

Clayton Hamblin
1953 Jackson
Lewis, KS 67552
(620) 324-5589

certifies that they accept the above listed water well that was drilled by Kelly's Water Well Service, Great Bend, Kansas, located approximately 3400' FSL & 690 FEL of Section 10 Township 27s Range 18w Kiowa County Kansas for domestic use only and when the well is no longer needed agrees to plug the well in accordance with the State Regulation KAR 28-30-7.

By signing this agreement, landowner releases Sterling Drilling Company from any further responsibilities relating to the water well described above. Landowner also agrees to allow Sterling Drilling use of this water well for any future drilling operations within 3,000 feet of this water well and occurring within the next 3 years from this date. A fee of \$250.00 would be paid to the landowner each time Sterling used this water well for said purpose. Sterling Drilling would be responsible for payment of any fees for state and/or county permits required at that time.

January 22, 2013
Date

[Signature]
Gary M Talbott
Operations Manager
Sterling Drilling Company

January 24, 2013
Date

[Signature]
Clayton Hamblin
Landowner

Copy of the WWC-5 and permits attached

[Signature]
[Signature]

RECEIVED
APR 15 2013
BUREAU OF WATER