

WATER WELL RECORD

Form WWC-5


Division of Water Resources App. No.

20130076

1 LOCATION OF WATER WELL: County: Kiowa Fraction 1/4 NW 1/4 SE 1/4 SE 1/4 Section Number 20 Township No. T 27 S Range Number R 18 [] E [x] W

Street/Rural Address of Well Location; if unknown, distance & direction from nearest town or intersection: If at owner's address, check here []. 4N, 1/2W of Greensburg, KS Global Positioning System (GPS) information: Latitude: Longitude: Elevation: Datum: [] WGS 84, [] NAD 83, [] NAD 27 Collection Method: [] GPS unit (Make/Model:) [] Digital Map/Photo, [] Topographic Map, [] Land Survey Est. Accuracy: [] <3 m, [] 3-5 m, [] 5-15 m, [] >15 m

2 WATER WELL OWNER: Clair Banda RR#, Street Address, Box #: 302 E. Iowa Ave. City, State, ZIP Code : Greensburg, KS 67054

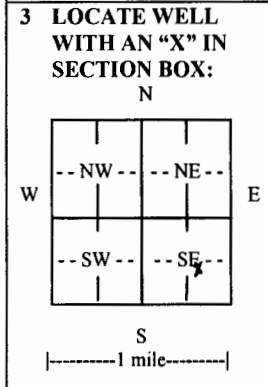

3 LOCATE WELL WITH AN 'X' IN SECTION BOX: N 4 DEPTH OF COMPLETED WELL 120 ft. Depth(s) Groundwater Encountered (1).45 ft. (2) ft. (3) ft. WELL'S STATIC WATER LEVEL .45 ft. below land surface measured on mo/day/yr. 02/05/13 Pump test data: Well water was ft. after hours pumping gpm EST. YIELD. 80 gpm Well water was ft. after hours pumping gpm Bore Hole Diameter in. to ft., and in. to ft. WELL WATER TO BE USED AS: [] Public water supply [] Geothermal [] Injection well [] Domestic [] Feedlot [x] Oil field water supply [] Dewatering [] Other (Specify below) [] Irrigation [] Industrial [] Domestic-lawn & garden [] Monitoring well Was a chemical/bacteriological sample submitted to Department? [] Yes [x] No If yes, mo/day/yr sample was submitted Water well disinfected? [x] Yes [] No

5 TYPE OF CASING USED: [] Steel [x] PVC [] Other CASING JOINTS: [x] Glued [] Clamped [] Welded [] Threaded Casing diameter .5 in. to .80 ft., Diameter in. to ft., Diameter in. to ft. Casing height above land surface .12 in., Weight 2.8 lbs./ft., Wall thickness or gauge No. Sch. 40 TYPE OF SCREEN OR PERFORATION MATERIAL: [] Steel [] Stainless Steel [x] PVC [] Other (Specify) [] Brass [] Galvanized Steel [] None used (open hole) SCREEN OR PERFORATION OPENINGS ARE: [] Continuous slot [] Mill slot [] Gauze wrapped [] Torch cut [] Drilled holes [] None (open hole) [] Louvered shutter [] Key punched [] Wire wrapped [x] Saw cut [] Other (specify) SCREEN-PERFORATED INTERVALS: From .80 ft. to .120 ft., From ft. to ft. GRAVEL PACK INTERVALS: From .23 ft. to .120 ft., From ft. to ft.

6 GROUT MATERIAL: [] Neat cement [] Cement grout [x] Bentonite [] Other Grout Intervals: From .0 ft. to .23 ft., From ft. to ft., From ft. to ft. What is the nearest source of possible contamination: [] Septic tank [] Lateral lines [] Pit privy [] Livestock pens [] Insecticide storage [] Other (specify below) [] Sewer lines [] Cesspool [] Sewage lagoon [] Fuel storage [] Abandoned water well [] Watertight sewer lines [] Seepage pit [] Feedyard [] Fertilizer storage [x] Oil well/gas well Direction from well East Distance from well .125

Table with columns: FROM, TO, LITHOLOGIC LOG, FROM, TO, LITHO. LOG (cont.) or PLUGGING INTERVALS. Rows include: 0-12 top sand, 12-31 clay, 31-90 sand and gravel, 90-95 clay, 95-120 sand and gravel. Includes Sterling Drilling Company, P O Box 1006, Pratt, KS 67124.

7 CONTRACTOR'S OR LANDOWNER'S CERTIFICATION: This water well was [x] constructed, [] reconstructed, or [] plugged under my jurisdiction and was completed on (mo/day/year) 02/05/13 and this record is true to the best of my knowledge and belief. Kansas Water Well Contractor's License No. 186 This Water Well Record was completed on (mo/day/year) 02/10/13 under the business name of Kelly's Water Well Service, Inc. by (signature) Kelly's Water Well Service, Inc.

INSTRUCTIONS: Use typewriter or ball point pen. PLEASE PRESS FIRMLY and PRINT clearly. Please fill in blanks and check the correct answers. Send three copies (white, blue, pink) to Kansas Department of Health and Environment, Bureau of Water, Geology Section, 1000 SW Jackson St., Suite 420, Topeka, Kansas 66612-1367. Telephone 785-296-5524. Send one copy to WATER WELL OWNER and retain one for your records. Include fee of \$5.00 for each constructed well. Visit us at http://www.kdheks.gov/waterwell/index.html.

STERLING DRILLING COMPANY

P.O. Box 1006
Pratt, Kansas 67124-1006
Phone (620) 672-9508
Federal ID #: 48-1185919

WATER WELL ACCEPTANCE AGREEMENT

Water Well Name: Banta 'F' #1-20
Water Well Location: Section 20 Township 27s Range 18w
County Kiowa
Water Well Location (footage): 870' FSL & 665 FEL Section 20
Board of Agriculture, Division of Water Resources Application Number: 20130076



This agreement between Sterling Drilling Company, P.O. Box 1006, Pratt, Kansas, 67124, and

Clair Banta
302 E Iowa
Greensburg KS 67054
(620) 723-3187

certifies that they accept the above listed water well that was drilled by Kelly's Water Well Service, Great Bend, Kansas, located approximately 870' FSL & 665 FEL of Section 20 Township 27s Range 18w Kiowa County Kansas for domestic use only and when the well is no longer needed agrees to plug the well in accordance with the State Regulation KAR 28-30-7.

By signing this agreement, landowner releases Sterling Drilling Company from any further responsibilities relating to the water well described above. Landowner also agrees to allow Sterling Drilling use of this water well for any future drilling operations within 3,000 feet of this water well and occurring within the next 3 years from this date. A fee of \$250.00 would be paid to the landowner each time Sterling used this water well for said purpose. Sterling Drilling would be responsible for payment of any fees for state and/or county permits required at that time.

February 18, 2013
Date
Gary M Talbott
Operations Manager
Sterling Drilling Company
Feb 22 2013
Date
Clair Banta
Clair Banta
Landowner

Copy of the WWC-5 and permits attached

RECEIVED
SEP 23 2013
BUREAU OF WATER