


WATER WELL RECORD Form WWC-5 KSA 82a-1212

1 LOCATION OF WATER WELL: Fraction Section Number Township Number Range Number
 COUNTY: KIOWA SW 1/4 SE 1/4 SW 1/4 1 T 27 S R 18 W

Distance and direction from nearest town or city street address of well if located within city?
 1 MILE EAST, 7.5 NORTH, 1.5 EAST OF GREENSBURG

2 WATER WELL OWNER: HANEY, JOHN Board of Agriculture, Division of Water Resources
 RR#, St. Address, Box # : 122 W IOWA Application Number:
 City, State, ZIP code : GREENSBURG, KS 67054-

3 LOCATE WELL'S LOCATION WITH AN "X" IN SECTION BOX:

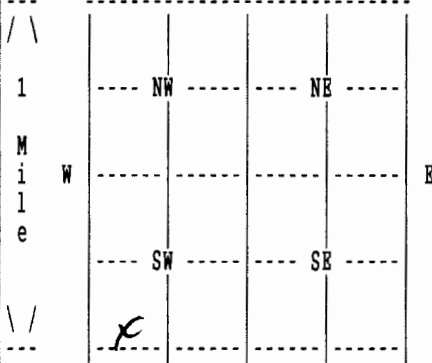

4 DEPTH OF COMPLETED WELL 126 ELEVATION: 0
 Depth(s) Groundwater Encountered 1. 0 ft. 2. 0 ft. 3. 0 ft.

WELL'S STATIC WATER LEVEL 24 ft. below land surface measured on mo/day/yr 06/28/06
 Pump test data: Well water was 0 ft. after 0 hours pumping 0 gpm
 Estimated Yield 0 gpm: Well water was 0 ft. after 0 hours pumping 0 gpm
 Bore Hole Diameter 8.75 in. to 126 ft., and in. to 0 ft.
 WELL WATER TO BE USED AS: LIVESTOCK

Was a chemical/bacteriological sample submitted to department? No ;
 If yes, mo/day/yr sample was submitted Water well disinfected? Yes

5 TYPE OF BLANK CASING USED: PVC CASING JOINTS: GLUED
 Blank casing diameter 5 in. to 116 ft., Dia in. to 0 ft., Dia in. to 0 ft.
 Casing height above land surface 12 in., weight 0 lbs/ft. Wall thickness or gauge No. 26
 TYPE OF SCREEN OR PERFORATION MATERIAL: PVC
 SCREEN OR PERFORATION OPENINGS ARE: SAW CUT

SCREEN PERFORATED INTERVALS: From 116 ft. to 126 ft., From 0 ft. to 0 ft.
 From 0 ft. to 0 ft., From 0 ft. to 0 ft.
 GRAVEL PACK INTERVALS: From 25 ft. to 126 ft., From 0 ft. to 0 ft.
 From 0 ft. to 0 ft., From 0 ft. to 0 ft.

6 GROUT MATERIAL BENTONITE
 Grout Intervals: From 2 ft. to 25 ft., From 0 ft. to 0 ft., From 0 ft. to 0 ft.
 What is the nearest source of possible contamination: SEPTIC TANK
 Direction from well? WEST How many feet? 5000

FROM	TO	LITHOLOGIC LOG	FROM	TO	PLUGGING INTERVALS
0	5	SILT AND SAND			
5	18	TAN CLAY			
18	74	SAND AND GRAVEL			
74	84	TAN CLAY			
84	126	SAND AND GRAVEL			
126	127	TAN CLAY			

7 CONTRACTOR'S OR LANDOWNER'S CERTIFICATION: This water well was Constructed under my jurisdiction and was completed on (mo/day/year) 06/28/06 and this record is true to the best of my knowledge and belief. Kansas Water Well Contractor's License No. 653 This Water Well Record was completed on (mo/day/yr) 06/28/06 under the business name of DAN HAYSE WATER WELL SERV by (signature) Dan Hayse