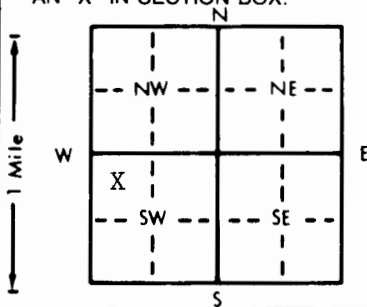


1 LOCATION OF WATER WELL: County: Kiowa Fraction: C $\frac{1}{4}$ NW $\frac{1}{4}$ SW $\frac{1}{4}$ Section Number: 3 Township Number: T 27 S Range Number: R 19W E/W

Distance and direction from nearest town or city street address of well if located within city?
1 W, 9 N, 3 W of Greensburg, Kansas

2 WATER WELL OWNER: Ed Baldwin TGT Baldwin A-3
 RR#, St. Address, Box #: 2032 S. Range 155 N. Market, #820 Board of Agriculture, Division of Water Resources
 City, State, ZIP Code: Colby, Ks. 67701 Wichita, Ks. 67202 Application Number: 960005

3 LOCATE WELL'S LOCATION WITH AN "X" IN SECTION BOX:  4 DEPTH OF COMPLETED WELL: 95 ft. ELEVATION: Unknown
 Depth(s) Groundwater Encountered: 1.50 ft. 2. ft. 3. ft.
 WELL'S STATIC WATER LEVEL: 50 ft. below land surface measured on mo/day/yr 1/9/96
 Pump test data: Well water was ft. after hours pumping gpm
 Est. Yield 50 gpm: Well water was ft. after hours pumping gpm
 Bore Hole Diameter: 7.7/8 in. to 95 ft., and in. to ft.
 WELL WATER TO BE USED AS:
 5 Public water supply 8 Air conditioning 11 Injection well
 1 Domestic 3 Feedlot 6 Oil field water supply 9 Dewatering 12 Other (Specify below)
 2 Irrigation 4 Industrial 7 Lawn and garden only 10 Monitoring well
 Was a chemical/bacteriological sample submitted to Department? Yes No ; If yes, mo/day/yr sample was submitted
 Water Well Disinfected? Yes No

5 TYPE OF BLANK CASING USED:
 1 Steel 3 RMP (SR) 5 Wrought iron 8 Concrete tile CASING JOINTS: Glued Clamped
 2 PVC 4 ABS 6 Asbestos-Cement 9 Other (specify below) Welded
 7 Fiberglass Threaded
 Blank casing diameter: 5 in. to 45 ft., Dia. in. to ft., Dia. in. to ft.
 Casing height above land surface: 12 in., weight 2,8 lbs./ft. Wall thickness or gauge No. Sch. 40
 TYPE OF SCREEN OR PERFORATION MATERIAL:
 1 Steel 3 Stainless steel 5 Fiberglass 7 PVC 10 Asbestos-cement
 2 Brass 4 Galvanized steel 6 Concrete tile 8 RMP (SR) 11 Other (specify)
 9 ABS 12 None used (open hole)
 SCREEN OR PERFORATION OPENINGS ARE:
 1 Continuous slot 3 Mill slot 5 Gauzed wrapped 8 Saw cut 11 None (open hole)
 2 Louvered shutter 4 Key punched 6 Wire wrapped 9 Drilled holes
 7 Torch cut 10 Other (specify)
 SCREEN-PERFORATED INTERVALS: From 45 ft. to 95 ft., From ft. to ft.
 GRAVEL PACK INTERVALS: From 50 ft. to 95 ft., From 20 ft. to 45 ft.

6 GROUT MATERIAL: 1 Neat cement 2 Cement grout 3 Bentonite 4 Other
 Grout Intervals: From 45 ft. to 50 ft., From 0 ft. to 20 ft., From ft. to ft.
 What is the nearest source of possible contamination:
 1 Septic tank 4 Lateral lines 7 Pit privy 10 Livestock pens 14 Abandoned water well
 2 Sewer lines 5 Cess pool 8 Sewage lagoon 11 Fuel storage 15 Oil well/Gas well
 3 Watertight sewer lines 6 Seepage pit 9 Feedyard 12 Fertilizer storage 16 Other (specify below)
 13 Insecticide storage
 Direction from well? SE How many feet? 175

FROM	TO	LITHOLOGIC LOG	FROM	TO	PLUGGING INTERVALS
0	4	Top soil and sand			
4	19	Brown sandy clay			
19	45	Fine sand and sand and gravel			
45	52	Clay			
52	90	Sand and gravel			
90	95	Clay			

7 CONTRACTOR'S OR LANDOWNER'S CERTIFICATION: This water well was (1) constructed, (2) reconstructed, or (3) plugged under my jurisdiction and was completed on (mo/day/year) 1/9/96 and this record is true to the best of my knowledge and belief. Kansas Water Well Contractor's License No. 186. This Water Well Record was completed on (mo/day/yr) 1/11/96 under the business name of Kelly's Water Well Service, Inc. by (signature) Alexis Sood

OFFICE USE ONLY
T
R
EW
SEC.
1/4
1/4
1/4