


WATER WELL RECORD Form WWC-5 KSA 82a-1212

1 LOCATION OF WATER WELL: Fraction Section Number Township Number Range Number  
 COUNTY: 049 KIOWA SE 1/4 SE 1/4 SW 1/4 30 T 27 S R 19 W

Distance and direction from nearest town or city street address of well if located within city?  
 5 N. 2 .E. OF MULLINVILLE,KS

2 WATER WELL OWNER: -GLEN HARRIS 378 Board of Agriculture, Division of Water Resources  
 RR#, St. Address, Box # : R.R.1 BOX 115  
 City, State, ZIP code : MULLINVILLE, KS 67109- Application Number:

3 LOCATE WELL'S LOCATION WITH AN 'X' IN SECTION BOX:

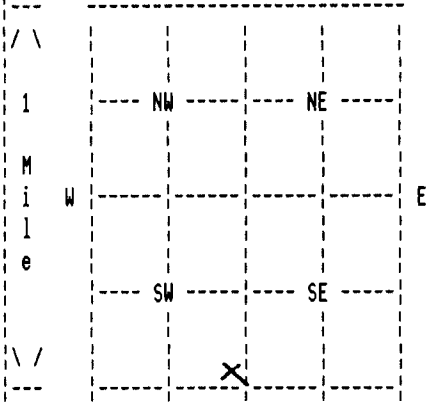

4 DEPTH OF COMPLETED WELL 82 ELEVATION: 0  
 Depth(s) Groundwater Encountered 1. 70 ft. 2. 0 ft. 3. 0 ft.

WELL'S STATIC WATER LEVEL 70 ft. below land surface measured on mo/day/yr  
 Pump testdata: Well water was 0 ft. after 0 hours pumping 0 gpm

Estimated Yield 0 gpm: Well water was 0 ft. after 0 hours pumping 0 gpm

Bore Hole Diameter 5 in. to 82 ft., and in. to 0 ft.

WELL WATER TO BE USED AS: 01 DOMESTIC

Was a chemical/bacteriological sample submitted to department? No ;  
 If yes, mo/day/yr sample was submitted Water well disinfected? Yes

5 TYPE OF BLANK CASING USED: 09 OTHER CASING JOINTS: GLUED  
 Blank casing diameter 5 in. to 80 ft., Dia in. to 0 ft., Dia in. to 0 ft.  
 Casing height above land surface 12 in., weight 0 lbs/ft. Wall thickness or gauge No. 26  
 TYPE OF SCREEN OR PERFORATION MATERIAL: NONE USED  
 SCREEN OR PERFORATION OPENINGS ARE: 11 NONE (OPEN)

SCREEN PERFORATED INTERVALS: From 0 ft. to 0 ft., From 0 ft. to 0 ft.  
 GRAVEL PACK INTERVALS: From 0 ft. to 0 ft., From 0 ft. to 0 ft.  
 From 0 ft. to 0 ft., From 0 ft. to 0 ft.

6 GROUT MATERIAL 03 BENTONITE  
 Grout Intervals: From 0 ft. to 10 ft., From 0 ft. to 0 ft., From 0 ft. to 0 ft.  
 What is the nearest source of possible contamination: CATTLE PASTURE  
 Direction from well? N How many feet? 80

FROM	TO	LITHOLOGIC LOG	FROM	TO	PLUGGING INTERVALS
			10	82	GRAVEL
			0	10	HOLEPLUG
			0	0	
			0	0	
			0	0	
			0	0	
			0	0	
			0	0	
			0	0	

7 CONTRACTOR'S OR LANDOWNER'S CERTIFICATION: This water well was Plugged under my jurisdiction and was completed on (mo/day/year) 12/10/96 and this record is true to the best of my knowledge and belief. Kansas Water Well Contractor's License No. 224 This Water Well Record was completed on (mo/day/yr) 12/21/96 under the business name of CARL HAYSE WATER WELL SVC by (signature) Carl Hayse