


WATER WELL RECORD Form WWC-5 KSA 82a-1212

1 LOCATION OF WATER WELL: Fraction Section Number Township Number Range Number
 COUNTY: KIOWA NW 1/4 NE 1/4 SW 1/4 32 T 27 S R 19 W

Distance and direction from nearest town or city street address of well if located within city?
 3 1/2 MILES EAST, 4 MILES NORTH, 1 MILE WEST OF MULLINVILLE

2 WATER WELL OWNER: MILLER, WILLIS EST.
 RR#, St. Address, Box # : PO BOX 509 Board of Agriculture, Division of Water Resources
 City, State, ZIP code : DODGE CITY, KS 67801- Application Number: ;

3 LOCATE WELL'S LOCATION WITH AN "X" IN SECTION BOX:

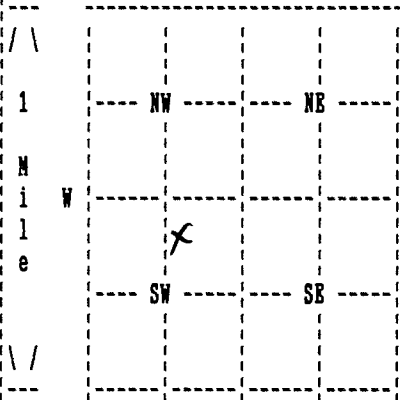

4 DEPTH OF COMPLETED WELL 130 ELEVATION: 0
 Depth(s) Groundwater Encountered 1. 85 ft. 2. 0 ft. 3. 0 ft.

WELL'S STATIC WATER LEVEL 85 ft. below land surface measured on mo/day/yr 11/29/01
 Pump testdata: Well water was 0 ft. after 0 hours pumping 0 gpm

Estimated Yield 0 gpm: Well water was 0 ft. after 0 hours pumping 0 gpm

Bore Hole Diameter 8.75 in. to 130 ft., and in. to 0 ft.

WELL WATER TO BE USED AS: LIVESTOCK ;

Was a chemical/bacteriological sample submitted to department? No ;
 If yes, mo/day/yr sample was submitted Water well disinfected? Yes

5 TYPE OF BLANK CASING USED: PVC CASING JOINTS: GLUED
 Blank casing diameter 5 in. to 120 ft., Dia in. to 0 ft., Dia in. to 0 ft.
 Casing height above land surface 12 in., weight 0 lbs/ft. Wall thickness or gauge No. 26
 TYPE OF SCREEN OR PERFORATION MATERIAL: PVC
 SCREEN OR PERFORATION OPENINGS ARE: SAW CUT

SCREEN PERFORATED INTERVALS: From 120 ft. to 130 ft., From 0 ft. to 0 ft.
 From 0 ft. to 0 ft., From 0 ft. to 0 ft.
 GRAVEL PACK INTERVALS: From 23 ft. to 130 ft., From 0 ft. to 0 ft.
 From 0 ft. to 0 ft., From 0 ft. to 0 ft.

6 GROUT MATERIAL BENTONITE
 Grout Intervals: From 2 ft. to 23 ft., From 0 ft. to 0 ft., From 0 ft. to 0 ft.
 What is the nearest source of possible contamination: SEPTIC TANK
 Direction from well? SOUTHEAST How many feet? 2500

FROM	TO	LITHOLOGIC LOG	FROM	TO	PLUGGING INTERVALS
0	18	SILT AND SAND			
18	57	TAN CLAY			
57	84	SAND AND GRAVEL			
84	98	TAN CLAY			
98	102	SAND AND GRAVEL			
102	114	TAN CLAY			
114	130	SAND AND GRAVEL			

7 CONTRACTOR'S OR LANDOWNER'S CERTIFICATION: This water well was Constructed under my jurisdiction and was completed on (mo/day/year) 11/29/01 and this record is true to the best of my knowledge and belief. Kansas Water Well Contractor's License No. 653 This Water Well Record was completed on (mo/day/yr) 12/19/01 under the business name of DAN HAYSE WATER WELL SVC. by (signature) *Don Hayse*