USE TYPEWRITER OR BALL POINT PEN-PRESS FIRMLY, PRINT CLEARLY.

WATER WELL RECORD
KSA 82a-1201-1215

Kansas Department of Health and Environment-Division of Environment
(Water well Contractors)
Topeka, Kansas 66620

1. Location of well:	County: Kiowa	Fraction: C / SW (1/4 1/4 1/4)	Section number: 11	Township number: T 27 S	Range number: R 19 E/W

2. Distance and direction from nearest town or city: 7 NORTH - 3 WEST OF. BREARSBURG

Street address of well location if in city:

3. Owner of well: Dewain Davis
R.R. or street: Rt. 1
City, state, zip code: Mullinville, Ks.

4. Locate with "X" in section below:

Sketch map:

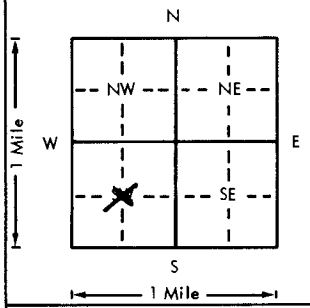

6. Bore hole dia. 29 in. Completion date
Well depth 185 ft. 10-21-76

7. __ Cable tool X Rotary __ Driven __ Dug
__ Hollow rod __ Jetted __ Bored __ Reverse rotary

8. Use: __ Domestic __ Public supply __ Industry
X Irrigation __ Air conditioning __ Stock
__ Lawn __ Oil field water __ Other

9. Casing: Material steel Height: Above or ~~below~~
Threaded ___ Welded X Surface 18 in.
RMP ___ PVC ___ Weight ___ lbs./ft.
Dia. 16 in. to 185 ft. depth Wall Thickness: inches or
Dia. ___ in. to ___ ft. depth gage No. 7

5. Type and color of material	From	To
Sandy Top Soil	0	4
Red Brown Clay	4	23
Sand Gravel	23	47
Brown Clay	47	53
Sand Gravel	53	117
Brown White Clay	117	128
Brown White Clay Sand Gravel	128	137
Sand Gravel	137	158
Med. Coarse Sand Gravel	158	183
Brown Clay	183	190
Yellow Clay	190	200
(Use a second sheet if needed)		

10. Screen: Manufacturer's name Doerrs
Type steel Dia. 16
Slot/~~gauze~~ 3/16 Length 80
Set between 105 ft. and 185 ft.
___ ft. and ___ ft.
Gravel pack? X Size range of material 1/2 3/4 3/8

11. Static water level: mo./day/yr.
52 ft. below land surface Date 10-4-76

12. Pumping level below land surfaces:
52 ft. after 1 hrs. pumping 1000 g.p.m.
___ ft. after ___ hrs. pumping ___ g.p.m.
Estimated maximum yield 1200 g.p.m.

13. Water sample submitted: mo./day/yr.
X Yes ___ No Date 10-4-76

14. Well head completion:
___ Pitless adapter ___ Inches above grade

15. Well grouted? X
With: ___ Neat cement ___ Bentonite X Concrete
Depth: From 0 ft. to 10 ft.

16. Nearest source of possible contamination:
ft. 4500 Direction NORTH Type CORRAL
Well disinfected upon completion? ___ Yes ___ No

17. Pump: ___ Not installed
Manufacturer's name Jacuzzi
Model number 4 IS 12 HP 80 Volts ___
Length of drop pipe 100 ft. capacity 1200 g.p.m.
Type:
___ Submersible X Turbine
___ Jet ___ Reciprocating
___ Centrifugal ___ Other

18. Elevation:

Topography:
___ Hill
___ Slope
X Upland
___ Valley

19. Remarks:

20. Water well contractor's certification:
This well was drilled under my jurisdiction and this report is true to the best of my knowledge and belief.
Rosencrantz-Bemis 134
Business name License No.
Address Great Bend, Ks.
Signed Fredia Dodson Date 11/10/76
Authorized representative

27 T 19 R E (W) 11 Sec CSW 1/4 1/4 1/4

Forward the white, blue and pink copies to the Department of Health and Environment

Form WWC-5

M1-1023