

Kiowa NW NW SW 11-27-19W

CORRECTION TO WATER WELL RECORD (WWC-5)

The following correction(s) was made to the attached WWC-5 log, in order to file the item or to rectify lacking or incorrect information.

Fraction (1/4 1/4 1/4) Section-Township-Range changed:

listed as _____

changed to _____

Other changes: Initial statements: Edwards County

Changed to: Kiowa County

Comments: _____

verification method: Written & legal descriptions, position on plat map, and Greensburg & Greensburg NE 1:24,000 topo. maps initials: DPH date: 2/28/2001

submitted by: Kansas Geological Survey, Data Resources Library, 1930 Constant Ave., Lawrence, KS 66047-3726
to: Kansas Dept of Health & Environment Bureau of Water Industrial Programs, Bldg 283, Forbes Field, KS 66620

WATER WELL RECORD Form WWC-5 KSA 82a-1212

1 LOCATION OF WATER WELL: Fraction Section Number Township Number Range Number
 COUNTY: 024 EDWARDS NW 1/4 NW 1/4 SW 1/4 11 T 27 S R 19 W

Distance and direction from nearest town or city street address of well if located within city?

4 W, 8 N. OF GREENSBURG


2 WATER WELL OWNER: HERRMANN, JOE 090
 RR#, St. Address, Box #: 415 PRAIRIE

Board of Agriculture, Division of Water Resources

City, State, ZIP code: KINSLEY, KS 67547-

Application Number:

3 LOCATE WELL'S LOCATION WITH AN "X" IN SECTION BOX:

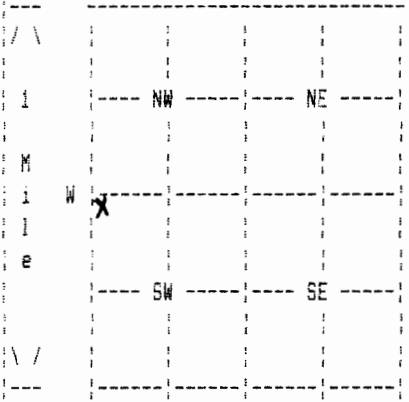

4 DEPTH OF COMPLETED WELL 82 ELEVATION:
 Depth(s) Groundwater Encountered 1. 61 ft. 2. ft. 3. ft.

WELL'S STATIC WATER LEVEL 61 ft. below land surface measured on mo/day/yr
 Pump test data: Well water was ft. after hours pumping gpm

Estimated Yield gpm: Well water was ft. after hours pumping gpm

Bore Hole Diameter 8.75 in. to 82 ft., and in. to ft.

WELL WATER TO BE USED AS: 01 DOMESTIC

Was a chemical/bacteriological sample submitted to department? No;
 If yes, mo/day/yr sample was submitted Water well disinfected? Yes

5 TYPE OF BLANK CASING USED: 02 PVC CASING JOINTS: GLUED

Blank casing diameter 5 in. to 62 ft., Dia in. to ft., Dia in. to ft.
 Casing height above land surface 12 in., weight lbs/ft. Wall thickness or gauge No. 26

TYPE OF SCREEN OR PERFORATION MATERIAL: 07 PVC

SCREEN OR PERFORATION OPENINGS ARE: 08 SAW CUT

SCREEN PERFORATED INTERVALS: From 62 ft. to 82 ft., From ft. to ft.
 From ft. to ft., From ft. to ft.
 GRAVEL PACK INTERVALS: From 25 ft. to 82 ft., From ft. to ft.
 From ft. to ft., From ft. to ft.

6 GROUT MATERIAL 03 BENTONITE

Grout intervals: From ft. to 25 ft., From ft. to ft., From ft. to ft.

What is the nearest source of possible contamination: CATTLE PASTURE

Direction from well? ALL How many feet?

FROM	TO	LITHOLOGIC LOG	FROM	TO	PLUGGING INTERVALS
	5	SILT & SAND			
5	38	BROWN CLAY			
38	82	05 SAND AND 17 GRAVEL			

7 CONTRACTOR'S OR LANDOWNER'S CERTIFICATION: This water well was Constructed under my jurisdiction and was completed on (mo/day/year) 8 /21/91 and this record is true to the best of my knowledge and belief. Kansas Water Well Contractor's License No. 224 This Water Well Record was completed on (mo/day/yr) 09/27/91 under the business name of CARL HAYSE WATER WELL SVC by (signature) Carl Hayse