


1 LOCATION OF WATER WELL: County: **Kiowa** Fraction: **C NW 1/4 SW 1/4** Section Number: **15** Township Number: **T 27 S** Range Number: **R 19W EW**

Distance and direction from nearest town or city street address of well if located within city?
6 N of Joy, Kansas

2 WATER WELL OWNER: **D. B. Rader** **Abercrombie Drilling Co.** **Rader #1**
 RR#, St. Address, Box #: **Mullinville, Ks. 801 Union Center** Board of Agriculture, Division of Water Resources
 City, State, ZIP Code: **67109** **Wichita, Kansas 67202** Application Number: **900274**

3 LOCATE WELL'S LOCATION WITH AN "X" IN SECTION BOX: 4 DEPTH OF COMPLETED WELL: **132** ft. ELEVATION: **Unknown**

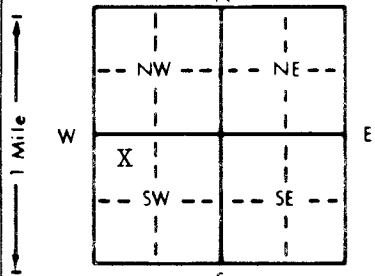

Depth(s) Groundwater Encountered: 1. **70** ft. 2. _____ ft. 3. _____ ft.
 WELL'S STATIC WATER LEVEL: **70** ft. below land surface measured on mo/day/yr **6/15/90**
 Pump test data: Well water was _____ ft. after _____ hours pumping _____ gpm
 Est. Yield: **60** gpm: Well water was _____ ft. after _____ hours pumping _____ gpm
 Bore Hole Diameter: **8** in. to **132** ft. and _____ in. to _____ ft.
 WELL WATER TO BE USED AS: 5 Public water supply 8 Air conditioning 11 Injection well
 1 Domestic 3 Feedlot 6 Oil field water supply 9 Dewatering 12 Other (Specify below)
 2 Irrigation 4 Industrial 7 Lawn and garden only 10 Monitoring well
 Was a chemical/bacteriological sample submitted to Department? Yes _____ No _____; If yes, mo/day/yr sample was submitted _____
 Water Well Disinfected? Yes _____ No _____

5 TYPE OF BLANK CASING USED: 5 Wrought iron 8 Concrete tile CASING JOINTS: Glued _____ Clamped _____
 1 Steel 3 RMP (SR) 6 Asbestos-Cement 9 Other (specify below) _____ Welded _____
 2 PVC 4 ABS 7 Fiberglass _____ Threaded _____

Blank casing diameter: **5** in. to **112** ft., Dia _____ in. to _____ ft., Dia _____ in. to _____ ft.
 Casing height above land surface: **12** in., weight **2.8** lbs./ft. Wall thickness or gauge No. **Sch. 40**

TYPE OF SCREEN OR PERFORATION MATERIAL: 7 PVC 10 Asbestos-cement
 1 Steel 3 Stainless steel 5 Fiberglass 8 RMP (SR) 11 Other (specify) _____
 2 Brass 4 Galvanized steel 6 Concrete tile 9 ABS 12 None used (open hole)

SCREEN OR PERFORATION OPENINGS ARE: 5 Gauzed wrapped 8 Saw cut 11 None (open hole)
 1 Continuous slot 3 Mill slot 6 Wire wrapped 9 Drilled holes
 2 Louvered shutter 4 Key punched 7 Torch cut 10 Other (specify) _____

SCREEN-PERFORATED INTERVALS: From _____ ft. to **112** ft., From _____ ft. to _____ ft.
 From _____ ft. to _____ ft., From _____ ft. to _____ ft.
 GRAVEL PACK INTERVALS: From _____ ft. to **132** ft., From _____ ft. to _____ ft.
 From _____ ft. to _____ ft., From _____ ft. to _____ ft.

6 GROUT MATERIAL: 1 Neat cement 2 Cement grout 3 Bentonite 4 Other _____
 Grout intervals: From **0** ft. to **20** ft., From _____ ft. to _____ ft., From _____ ft. to _____ ft.

What is the nearest source of possible contamination:
 1 Septic tank 4 Lateral lines 7 Pit privy 10 Livestock pens 14 Abandoned water well
 2 Sewer lines 5 Cess pool 8 Sewage lagoon 11 Fuel storage 15 Oil well/Gas well
 3 Watertight sewer lines 6 Seepage pit 9 Feedyard 12 Fertilizer storage 16 Other (specify below)
 13 Insecticide storage
 Direction from well? **South** How many feet? **60**

FROM	TO	LITHOLOGIC LOG	FROM	TO	PLUGGING INTERVALS
0	35	Clay			
35	62	Sand and gravel			
62	102	Clay			
102	132	Sand and gravel			

7 CONTRACTOR'S OR LANDOWNER'S CERTIFICATION: This water well was (1) constructed, (2) reconstructed, or (3) plugged under my jurisdiction and was completed on (mo/day/year) **6/15/90** and this record is true to the best of my knowledge and belief. Kansas Water Well Contractor's License No. **186** This Water Well Record was completed on (mo/day/yr) **7/20/90** under the business name of **Kelly's Water Well Service** by (signature) *Deeey Doad*

INSTRUCTIONS: Use typewriter or ball point pen. PLEASE PRESS FIRMLY and PRINT clearly. Please fill in blanks, underline or circle the correct answers. Send top three copies to Kansas Department of Health and Environment, Bureau of Water, Topeka, Kansas 66620-7320. Telephone: 913-296-5545. Send one to WATER WELL OWNER and retain one for your records.

OFFICE USE ONLY
T
R
F/W
SEC.
1/4
1/4
1/4