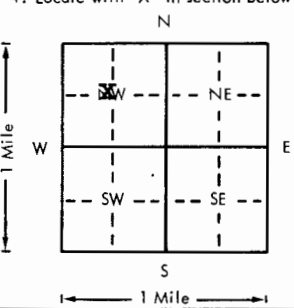


USE TYPEWRITER OR BALL POINT PEN-PRESS FIRMLY, PRINT CLEARLY.

WATER WELL RECORD  
KSA 82a-1201-1215

Kansas Department of Health and Environment-Division of Environment  
(Water well Contractors)  
Topeka, Kansas 66620

1. Location of well:	County <b>Kiowa</b>	Fraction <b>1/4 cnw 1/4 1/4</b>	Section number <b>18</b>	Township number <b>T 27 S R 19W E/W</b>	Range number
2. Distance and direction from nearest town or city: <b>7n Mullinville Ks.</b>			3. Owner of well: <b>Gabbert-Jones Inc.</b> R.R. or street: <b>830 Sutton Pl</b> City, state, zip code: <b>Wichita, Ks 67202</b>		
4. Locate with "X" in section below: 			Sketch map:		
5. Type and color of material			From	To	6. Bore hole dia. <b>8</b> in. Completion date <b>8-30-77</b> Well depth <b>75</b> ft.
Top Soil-Clay			0	30	7. <input type="checkbox"/> Cable tool <input checked="" type="checkbox"/> Rotary <input type="checkbox"/> Driven <input type="checkbox"/> Dug <input type="checkbox"/> Hollow rod <input type="checkbox"/> Jetted <input type="checkbox"/> Bored <input type="checkbox"/> Reverse rotary
Sandy Clay			30	45	8. Use: <input type="checkbox"/> Domestic <input type="checkbox"/> Public supply <input type="checkbox"/> Industry <input type="checkbox"/> Irrigation <input type="checkbox"/> Air conditioning <input type="checkbox"/> Stock <input type="checkbox"/> Lawn <input checked="" type="checkbox"/> Oil field water <input type="checkbox"/> Other
Sand			45	50	9. Casing: Material <input type="checkbox"/> Height: Above <input checked="" type="checkbox"/> Below Threaded <input type="checkbox"/> Welded <input type="checkbox"/> Surface <b>12</b> in. RMP <input type="checkbox"/> PVC <input checked="" type="checkbox"/> Weight <input type="checkbox"/> lbs./ft. Dia. <b>5</b> in. to <b>75</b> ft. depth Wall Thickness: inches or Dia. <input type="checkbox"/> in. to <input type="checkbox"/> ft. depth gage No. <b>sch 40</b>
Sand-Gravel			50	75	10. Screen: Manufacturer's name <b>Jetstream</b> Type <b>pvc</b> Dia. <b>5"</b> Slot/gauze <b>1/32"</b> Length <b>20'</b> Set between <b>55</b> ft. and <b>75</b> ft. ft. and <input type="checkbox"/> ft. Gravel pack? <input checked="" type="checkbox"/> Size range of material <b>1/8-3/4</b>
					11. Static water level: <input type="checkbox"/> mo./day/yr. <b>40</b> ft. below land surface Date <b>8-30-77</b>
					12. Pumping level below land surfaces: <input type="checkbox"/> ft. after <input type="checkbox"/> hrs. pumping <input type="checkbox"/> g.p.m. <input type="checkbox"/> ft. after <input type="checkbox"/> hrs. pumping <input type="checkbox"/> g.p.m. Estimated maximum yield <b>50</b> g.p.m.
					13. Water sample submitted: <input type="checkbox"/> mo./day/yr. <input type="checkbox"/> Yes <input checked="" type="checkbox"/> No Date <input type="checkbox"/>
					14. Well head completion: <input type="checkbox"/> Pitless adapter <b>12</b> Inches above grade
					15. Well grouted? <input checked="" type="checkbox"/> With: <input type="checkbox"/> Neat cement <input checked="" type="checkbox"/> Bentonite <input type="checkbox"/> Concrete Depth: From <b>0</b> ft. to <b>10</b> ft.
					16. Nearest source of possible contamination: <b>oil test</b> ft. <b>50</b> Direction <b>s</b> Type <b>oil test</b> Well disinfected upon completion? <input type="checkbox"/> Yes <input checked="" type="checkbox"/> No
					17. Pump: <input checked="" type="checkbox"/> Not installed Manufacturer's name <input type="checkbox"/> Model number <input type="checkbox"/> HP <input type="checkbox"/> Volts <input type="checkbox"/> Length of drop pipe <input type="checkbox"/> ft. capacity <input type="checkbox"/> g.p.m. Type: <input type="checkbox"/> Submersible <input type="checkbox"/> Turbine <input type="checkbox"/> Jet <input type="checkbox"/> Reciprocating <input type="checkbox"/> Centrifugal <input type="checkbox"/> Other
(Use a second sheet if needed)					
18. Elevation:  Topography: <input type="checkbox"/> Hill <input type="checkbox"/> Slope <input checked="" type="checkbox"/> Upland <input type="checkbox"/> Valley	19. Remarks:		20. Water well contractor's certification: This well was drilled under my jurisdiction and this report is true to the best of my knowledge and belief. <b>Kellys Waterwell Ser 186</b> Business name License No. Address <b>82 Great Bend, Ks.</b> Signed <b>Sully Price</b> Date <b>7-30-77</b> Authorized representative		

27 19W 18  
 Sec  
 1/4 1/4 1/4 1/4

Forward the white, blue and pink copies to the Department of Health and Environment

Form WWC-5