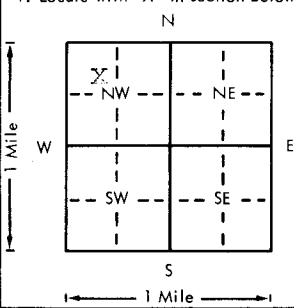


USE TYPEWRITER OR BALL POINT PEN-PRESS FIRMLY, PRINT CLEARLY.

WATER WELL RECORD
KSA 82a-1201-1215

Kansas Department of Health and Environment-Division of Environment
(Water well Contractors)
Topeka, Kansas 66620

1. Location of well:	County Kiowa	Fraction 1/4 cnw 1/4 nw 1/4	Section number 22	Township number T 27 S R 19W E/W	Range number
2. Distance and direction from nearest town or city: Street address of well location if in city:			3. Owner of well: Gabbert-Jones Inc. R.R. or street: 830 Sutton Pl. City, state, zip code: Wichita, Ks.		
4. Locate with "X" in section below: 			Sketch map:		
5. Type and color of material			From	To	6. Bore hole dia. 8 in. Completion date _____ Well depth 92 ft. 1-6-78
					7. <input type="checkbox"/> Cable tool <input checked="" type="checkbox"/> Rotary <input type="checkbox"/> Driven <input type="checkbox"/> Dug <input type="checkbox"/> Hollow rod <input type="checkbox"/> Jetted <input type="checkbox"/> Bored <input type="checkbox"/> Reverse rotary
					8. Use: <input type="checkbox"/> Domestic <input type="checkbox"/> Public supply <input type="checkbox"/> Industry <input type="checkbox"/> Irrigation <input type="checkbox"/> Air conditioning <input type="checkbox"/> Stock <input type="checkbox"/> Lawn <input checked="" type="checkbox"/> Oil field water <input type="checkbox"/> Other
					9. Casing: Material _____ Height: Above ground _____ Threaded _____ Welded _____ Surface 12 in. RMP _____ PVC <input checked="" type="checkbox"/> Weight 2.8 lbs./ft. Dia. 5 in. to 92 ft. depth Wall thickness: inches or Dia. _____ in. to _____ ft. depth gage No. sch 40
					10. Screen: Manufacturer's name Jetstream Type pvc Dia. 5" Slot/gauze 1/32" Length 30" Set between 62 ft. and 92 ft. _____ ft. and _____ ft. Gravel pack? <input checked="" type="checkbox"/> Size range of material 1/8-3/4"
					11. Static water level: _____ mo./day/yr. 36 ft. below land surface Date 1-6-78
					12. Pumping level below land surfaces: _____ ft. after _____ hrs. pumping _____ g.p.m. _____ ft. after _____ hrs. pumping _____ g.p.m. Estimated maximum yield 60 g.p.m.
					13. Water sample submitted: _____ mo./day/yr. <input type="checkbox"/> Yes <input checked="" type="checkbox"/> No Date _____
					14. Well head completion: _____ <input type="checkbox"/> Pitless adapter 12 Inches above grade
					15. Well grouted? <input checked="" type="checkbox"/> With: <input type="checkbox"/> Neat cement <input checked="" type="checkbox"/> Bentonite _____ Concrete _____ Depth: From 0 ft. to 10 ft.
					16. Nearest source of possible contamination: oil ft. 50 Direction sw Type test Well disinfected upon completion? _____ Yes <input checked="" type="checkbox"/> No
					17. Pump: <input checked="" type="checkbox"/> Not installed Manufacturer's name _____ Model number _____ HP _____ Volts _____ Length of drop pipe _____ ft. capacity _____ g.p.m. Type: <input type="checkbox"/> Submersible <input type="checkbox"/> Turbine <input type="checkbox"/> Jet <input type="checkbox"/> Reciprocating <input type="checkbox"/> Centrifugal <input type="checkbox"/> Other
(Use a second sheet if needed)					
18. Elevation:	19. Remarks:		20. Water well contractor's certification: This well was drilled under my jurisdiction and this report is true to the best of my knowledge and belief. Kellys Waterwell Ser 186 Business name License No. _____ Address R2 Great Bend, Ks. Signed Kelly Price Date 5-12-79 Authorized representative		
Topography: <input type="checkbox"/> Hill <input type="checkbox"/> Slope <input checked="" type="checkbox"/> Upland <input type="checkbox"/> Valley					

R2 19W 22 NW 1/4 1/4

Forward the white, blue and pink copies to the Department of Health and Environment

Form WWC-5