


1 LOCATION OF WATER WELL: Fraction S 1/2 1/4 SE 1/4 SW 1/4 Section Number 22 Township Number T 27 Range Number R 19  
 County: Kiowa

Distance and direction from nearest town or city street address of well if located within city?  
4 3/4 North, 3 1/2 West, 330 North of 54 & 183 Jct. near Greensburg, Ks.

2 WATER WELL OWNER: Abercrombie Drilling Company  
 RR#, St. Address, Box #: Box 56 Rt. 1 Board of Agriculture, Division of Water Resources  
 City, State, ZIP Code: Great Bend, Ks. 67530 Lease: Breising A#3 Application Number:

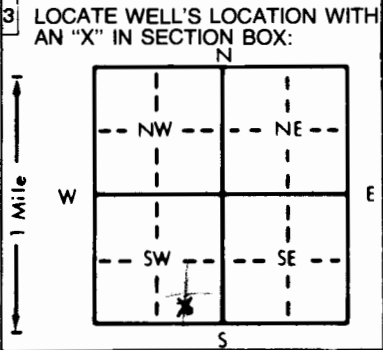

4 DEPTH OF COMPLETED WELL: 80' ft. ELEVATION:  
 Depth(s) Groundwater Encountered 1. 58' ft. 2. ft. 3. ft.  
 WELL'S STATIC WATER LEVEL: 58' ft. below land surface measured on mo/day/yr 29 June 85  
 Pump test data: Well water was ft. after hours pumping gpm  
 Est. Yield 80 gpm: Well water was ft. after hours pumping gpm  
 Bore Hole Diameter: 10 in. to 80 ft., and in. to ft.  
 WELL WATER TO BE USED AS:  
 1 Domestic 3 Feedlot 6 Oil field water supply 9 Dewatering 12 Other (Specify below)  
 2 Irrigation 4 Industrial 7 Lawn and garden only 10 Observation well  
 Was a chemical/bacteriological sample submitted to Department? Yes No X; If yes, mo/day/yr sample was submitted  
 Water Well Disinfected? Yes X No

5 TYPE OF BLANK CASING USED:  
 1 Steel 3 RMP (SR) 5 Wrought iron 8 Concrete tile CASING JOINTS: Glued X Clamped  
3 PVC 4 ABS 6 Asbestos-Cement 9 Other (specify below) Welded  
 7 Fiberglass Threaded  
 Blank casing diameter 5 in. to 60 ft., Dia. in. to ft., Dia. in. to ft.  
 Casing height above land surface 12 in., weight 2.34 lbs./ft. Wall thickness or gauge No. .214  
 TYPE OF SCREEN OR PERFORATION MATERIAL:  
 1 Steel 3 Stainless steel 5 Fiberglass 7 PVC 10 Asbestos-cement  
 2 Brass 4 Galvanized steel 6 Concrete tile 9 ABS 11 Other (specify)  
 12 None used (open hole)  
 SCREEN OR PERFORATION OPENINGS ARE:  
 1 Continuous slot 3 Mill slot 5 Gauzed wrapped 8 Saw cut 11 None (open hole)  
 2 Louvered shutter 4 Key punched 6 Wire wrapped 9 Drilled holes  
 7 Torch cut 10 Other (specify)  
 SCREEN-PERFORATED INTERVALS: From 60' ft. to 80' ft., From ft. to ft.  
 From ft. to ft., From ft. to ft.  
 GRAVEL PACK INTERVALS: From 10' ft. to 80' ft., From ft. to ft.  
 From ft. to ft., From ft. to ft.

6 GROUT MATERIAL: 1 Neat cement 2 Cement grout 3 Bentonite 4 Other  
 Grout Intervals: From 0 ft. to 10 ft., From ft. to ft., From ft. to ft.  
 What is the nearest source of possible contamination:  
 1 Septic tank 4 Lateral lines 7 Pit privy 10 Livestock pens 14 Abandoned water well  
 2 Sewer lines 5 Cess pool 8 Sewage lagoon 11 Fuel storage 15 Oil well/Gas well  
 3 Watertight sewer lines 6 Seepage pit 9 Feedyard 12 Fertilizer storage 16 Other (specify below)  
 13 Insecticide storage None

Direction from well? How many feet?

FROM	TO	LITHOLOGIC LOG	FROM	TO	LITHOLOGIC LOG
0	2	Soil, sandy			
2	12	Sand, fine to coarse			
12	21	Clay, tan			
<del>21</del>	<del>46</del>	<del>Sand, fine to coarse and coarse gravel</del>			
21	46	Sand, fine to coarse and fine to coarse gravel			
46	80	Sand, coarse and coarse gravel			

7 CONTRACTOR'S OR LANDOWNER'S CERTIFICATION: This water well was constructed (2) reconstructed, or (3) plugged under my jurisdiction and was completed on (mo/day/year) 29 June 85 and this record is true to the best of my knowledge and belief. Kansas Water Well Contractor's License No. 325 This Water Well Record was completed on (mo/day/yr) 20 Aug 85 under the business name of Central Well & Pump, Inc. by (signature) [Signature]

INSTRUCTIONS: Use typewriter or ball point pen, PLEASE PRESS FIRMLY and PRINT clearly. Please fill in blanks, underline or circle the correct answers. Send top three copies to Kansas Department of Health and Environment, Division of Environment, Environmental Geology Section, Topeka, KS 66620. Send one to WATER WELL OWNER and retain one for your records.

OFFICE USE ONLY