USE TYPEWRITER OR BALL POINT PEN-PRESS FIRMLY, PRINT CLEARLY.

WATER WELL RECORD
KSA 82a-1201-1215

Kansas Department of Health and Environment-Division of Environment
(Water well Contractors)
Topeka, Kansas 66620

1. Location of well:	County: Kiowa	Fraction: NW 1/4 SW 1/4 SE 1/4	Section number: 25	Township number: T 27 S	Range number: R 19 E/W

2. Distance and direction from nearest town or city: 4N 2½W
Street address of well location if in city: Greensburg Kans

3. Owner of well: Robert James
R.R. or street: Mullinville
City, state, zip code: Kansas

4. Locate with "X" in section below:

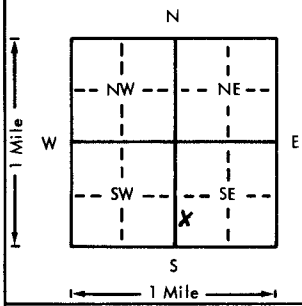

Sketch map:

6. Bore hole dia. 8 3/4 in. Completion date 12-10-76
Well depth 105 ft.

7. __ Cable tool X Rotary __ Driven __ Dug
__ Hollow rod __ Jetted __ Bored __ Reverse rotary

8. Use: __ Domestic __ Public supply __ Industry
__ Irrigation __ Air conditioning X Stock
__ Lawn __ Oil field water __ Other

9. Casing: Material PVC
Threaded ___ Welded ___
RMP X PVC ___
Dia. 5 in. to 105 ft. depth
Dia. ___ in. to ___ ft. depth
Height: Above or below Surface 22 in.
Weight 200 lbs./ft.
Wall Thickness: inches or gage No. ___

5. Type and color of material	From	To
Top Soil (Blow Sand)	0	2
Sandy Clay	2	17
Clay (Tan)	17	27
Sandy Clay	27	36
Gravel - Fine To 1/4	36	50
" " Fine To 1"	50	105
(Use a second sheet if needed)		

10. Screen: Manufacturer's name Sunflower Plastics
Type RMP Dia. 5"
Slot/gauze Slot Length 20
Set between 85 ft. and 105 ft.
___ ft. and ___ ft.
Gravel pack? Yes Size range of material 1/4 - 1/2

11. Static water level: 38 ft. below land surface Date 12-10-76 mo./day/yr.

12. Pumping level below land surfoces:
38 ft. after ___ hrs. pumping 15 g.p.m.
___ ft. after ___ hrs. pumping ___ g.p.m.
Estimated maximum yield 50 g.p.m.

13. Water sample submitted: mo./day/yr.
__ Yes X No Date ___

14. Well head completion:
__ Pitless adapter 22 Inches above grade

15. Well grouted? Yes
With: X Neat cement ___ Bentonite ___ Concrete
Depth: From 0 ft. to 10 ft.

16. Nearest source of possible contamination:
ft. ___ Direction ___ Type Livestock
Well disinfected upon completion? ___ Yes X No

17. Pump: __ Not installed
Manufacturer's name Gould
Model number ___ HP 3/4 Volts 220
Length of drop pipe 85 ft. capacity 15 g.p.m.
Type:
X Submersible __ Turbine
__ Jet __ Reciprocating
__ Centrifugal __ Other

18. Elevation:
Topography:
__ Hill
__ Slope
X Upland
__ Valley

19. Remarks:

20. Water well contractor's certification:
This well was drilled under my jurisdiction and this report is true to the best of my knowledge and belief.
Business name Carl Hayes Water Well Serv. License No. 224
Address 603 S. Maple Greensburg
Signed Carl Hayes Date 12-10-76
Authorized representative

T 27 R 19 E (W) Sec 25 1/4 NW 1/4 SW 1/4 SE 1/4

Forward the white, blue and pink copies to the Department of Health and Environment

Form WWC-5

MI-1029