USE TYPEWRITER OR BALL POINT PEN-PRESS FIRMLY, PRINT CLEARLY.

WATER WELL RECORD
KSA 82a-1201-1215

Kansas Department of Health and Environment-Division of Environment
(Water well Contractors)
Topeka, Kansas 66620

1. Location of well:	County	Fraction	Section number	Township number	Range number
	Kiowa	1/4 C 1/4 NW 1/4	35	T 27 S	R 19 E (W)

2. Distance and direction from nearest town or city:
4½-N 5 3/4-E from mullinville, ks.
Street address of well location if in city:

3. Owner of well: Butch Pyle
R.R. or street: 106 Plaza Terrace
City, state, zip code: Dodge City, Kansas 67801

4. Locate with "X" in section below:

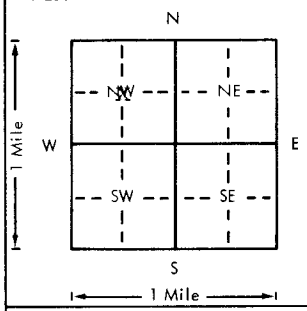

Sketch map:

6. Bore hole dia. 29 in. Completion date
X Well depth 162 ft. 3-28-78

7. __ Coble tool X Rotary __ Driven __ Dug
__ Hollow rod __ Jetted __ Bored __ Reverse rotary

8. Use: __ Domestic __ Public supply __ Industry
X Irrigation __ Air conditioning __ Stock
__ Lawn __ Oil field water __ Other

9. Casing: Material steel Height: Above or below
Threaded ___ Welded ___ Surface 18 in.
RMP ___ PVC ___ Weight ___ lbs./ft.
Dia. 16 in. to 162 ft. depth Wall Thickness: inches or
Dia. ___ in. to ___ ft. depth gage No. 7

5. Type and color of material	From	To
sandy top soil	0	5
brown sandy clay	5	38
sand & gravel	38	90
yellow brown clay	90	93
sand & gravel	93	161

(Use a second sheet if needed)

10. Screen: Manufacturer's name Doerrs
Type steeel Dia.
Slot/gauze 3/16 Length 60
Set between 102 ft. and 162 ft.
ft. and ft.
Gravel pack? X Size range of material 3/4 3/8

11. Static water level: mo./day/yr.
66 ft. below land surface Date 8-5-77

12. Pumping level below land surfaces:
68 ft. after 1 hrs. pumping 600 g.p.m.
ft. after hrs. pumping g.p.m.
Estimated maximum yield 1400+ g.p.m.

13. Water sample submitted: mo./day/yr.
X Yes ___ No Date 8-5-77

14. Well head completion:
___ Pitless adapter ___ Inches above grade

15. Well grouted? X
With: X Neat cement ___ Bentonite ___ Concrete
Depth: From 0 ft. to 10 ft.

16. Nearest source of possible contamination:
ft. ½-8 mile Location south Type septic
Well disinfected upon completion? X Yes ___ No

17. Pump: ___ Not installed
Manufacturer's name W.L.R.
Model number 4-12BU HP 80 Volts
Length of drop pipe 130 ft. capacity 1100 g.p.m.
Type:
___ Submersible X Turbine
___ Jet ___ Reciprocating
___ Centrifugal ___ Other

18. Elevation:

Topography:
___ Hill
___ Slope
X Upland
___ Valley

19. Remarks:
The test hole is not always as deep as the well.

20. Water well contractor's certification:
This well was drilled under my jurisdiction and this report is true to the best of my knowledge and belief.
Rosencrantz-Bemis 134
Business name License No.
Address Great Bend, Kansas 67530
X Signed Sandy Kilgore Date 6-19-79
Authorized representative

T 27 R 19 E (W) Sec 35 1/4 1/4 1/4 1/4 C NW

Forward the white, blue and pink copies to the Department of Health and Environment

Form WWC-5

M1-1023