


WATER WELL RECORD Form WWC-5 KSA 82a-1212

1 LOCATION OF WATER WELL: Fraction Section Number Township Number Range Number
COUNTY: KIOWA NW 1/4 SE 1/4 SE 1/4 26 T 27 S R 19 W

Distance and direction from nearest town or city street address of well if located within city?
3 1/2 MILES NORTH, 3 1/2 MILES WEST OF GREENSBURG

2 WATER WELL OWNER: TGT PETROLEUM CORPORATION
RR#, St. Address, Box # : PO BOX 75097 Board of Agriculture, Division of Water Resources
City, State, ZIP code : WICHITA, KS 67275-0097 Application Number: 20030282

3 LOCATE WELL'S LOCATION WITH AN "X" IN SECTION BOX:

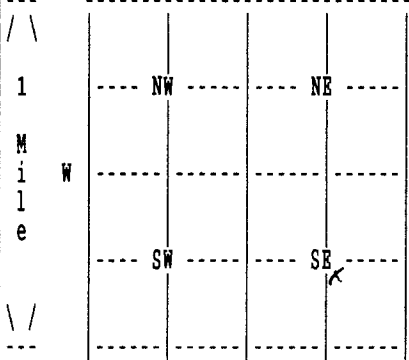

4 DEPTH OF COMPLETED WELL 144 ELEVATION: 0
Depth(s) Groundwater Encountered 1. 0 ft. 2. 0 ft. 3. 0 ft.

WELL'S STATIC WATER LEVEL 76 ft. below land surface measured on mo/day/yr 01/09/04
Pump test data: Well water was 0 ft. after 0 hours pumping 0 gpm
Estimated Yield 0 gpm: Well water was 0 ft. after 0 hours pumping 0 gpm
Bore Hole Diameter 8.75 in. to 150 ft., and in. to 0 ft.

WELL WATER TO BE USED AS: OIL FIELD
Was a chemical/bacteriological sample submitted to department? No ;
If yes, mo/day/yr sample was submitted Water well disinfected? Yes

5 TYPE OF BLANK CASING USED: PVC CASING JOINTS: GLUED
Blank casing diameter 5 in. to 124 ft., Dia in. to 0 ft., Dia in. to 0 ft.
Casing height above land surface 12 in., weight 0 lbs/ft. Wall thickness or gauge No. 26
TYPE OF SCREEN OR PERFORATION MATERIAL: PVC
SCREEN OR PERFORATION OPENINGS ARE: SAW CUT

SCREEN PERFORATED INTERVALS: From 124 ft. to 144 ft., From 0 ft. to 0 ft.
From 0 ft. to 0 ft., From 0 ft. to 0 ft.
GRAVEL PACK INTERVALS: From 22 ft. to 144 ft., From 0 ft. to 0 ft.
From 0 ft. to 0 ft., From 0 ft. to 0 ft.

6 GROUT MATERIAL BENTONITE
Grout Intervals: From 0 ft. to 22 ft., From 0 ft. to 0 ft., From 0 ft. to 0 ft.
What is the nearest source of possible contamination: OIL/GAS WELL
Direction from well? SOUTH How many feet? 100

Table with columns: FROM, TO, LITHOLOGIC LOG, FROM, TO, PLUGGING INTERVALS. Rows describe geological layers: SILT AND SAND, TAN CLAY, SAND, TAN CLAY, SAND AND GRAVEL, TAN CLAY, SAND AND GRAVEL.

7 CONTRACTOR'S OR LANDOWNER'S CERTIFICATION: This water well was Constructed under my jurisdiction and was completed on (mo/day/year) 01/09/04 and this record is true to the best of my knowledge and belief Kansas
Water Well Contractor's License No. 653A This Water Well Record was completed on (mo/day/yr) 05/20/04
under the business name of DAN HAYSE WATER WELL SERV by (signature) Dan Hayse