


WATER WELL RECORD Form WWC-5 KSA 82a-1212

1 LOCATION OF WATER WELL: COUNTY: KIOWA Fraction NE 1/4 NW 1/4 NE 1/4 Section Number 19 Township Number T 27 S Range Number R 19 W

Distance and direction from nearest town or city street address of well if located within city? 6.5 MILES NORTH, 2 MILES EAST OF MULLINVILLE

2 WATER WELL OWNER: MCFADDEN, BOYD RR#, St. Address, Box #: RT1 City, State, ZIP code: MULLINVILLE, KS 67109- Board of Agriculture, Division of Water Resources Application Number:

3 LOCATE WELL'S LOCATION WITH AN "X" IN SECTION BOX:

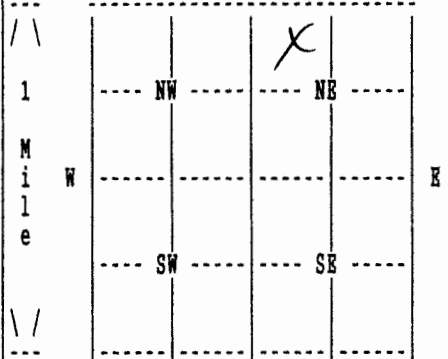

4 DEPTH OF COMPLETED WELL 138 ELEVATION: 0 Depth(s) Groundwater Encountered 1. 0 ft. 2. 0 ft. 3. 0 ft.

WELL'S STATIC WATER LEVEL 74 ft. below land surface measured on mo/day/yr 09/11/09 Pump test data: Well water was 0 ft. after 0 hours pumping 0 gpm

Estimated Yield 0 gpm: Well water was 0 ft. after 0 hours pumping 0 gpm

Bore Hole Diameter 8.75 in. to 138 ft., and in. to 0 ft.

WELL WATER TO BE USED AS: LIVESTOCK

Was a chemical/bacteriological sample submitted to department? No; If yes, mo/day/yr sample was submitted Water well disinfected? Yes

5 TYPE OF BLANK CASING USED: PVC CASING JOINTS: GLUED Blank casing diameter 5 in. to 118 ft., Dia in. to 0 ft., Dia in. to 0 ft. Casing height above land surface 24 in., weight 0 lbs/ft. Wall thickness or gauge No. 26 TYPE OF SCREEN OR PERFORATION MATERIAL: PVC SCREEN OR PERFORATION OPENINGS ARE: SAW CUT

SCREEN PERFORATED INTERVALS: From 118 ft. to 138 ft., From 0 ft. to 0 ft. From 0 ft. to 0 ft., From 0 ft. to 0 ft. GRAVEL PACK INTERVALS: From 24 ft. to 138 ft., From 0 ft. to 0 ft. From 0 ft. to 0 ft., From 0 ft. to 0 ft.

6 GROUT MATERIAL BENTONITE Grout Intervals: From 1 ft. to 24 ft., From 0 ft. to 0 ft., From 0 ft. to 0 ft. What is the nearest source of possible contamination: SEPTIC TANK Direction from well? SOUTHWEST How many feet? 4000

Table with columns: FROM, TO, LITHOLOGIC LOG, FROM, TO, PLUGGING INTERVALS. Rows show depth intervals and lithology: 0-11 SILT AND SAND, 11-26 TAN CLAY, 26-79 SAND AND GRAVEL, 79-124 TAN CLAY, 124-137 SAND AND GRAVEL, 137-138 TAN CLAY.

7 CONTRACTOR'S OR LANDOWNER'S CERTIFICATION: This water well was Constructed under my jurisdiction and was completed on (mo/day/year) 09/11/09 and this record is true to the best of my knowledge and belief. Kansas Water Well Contractor's License No. 653 This Water Well Record was completed on (mo/day/yr) 09/11/09 under the business name of DAN HAYSE WATER WELL SERV by (signature) Dan Hayse

White