


WATER WELL RECORD Form WWC-5 KSA 82a-1212

1 LOCATION OF WATER WELL: Fraction Section Number Township Number Range Number  
 COUNTY: KIOWA SW 1/4 NW 1/4 NW 1/4 29 T 27 S R 19 W

Distance and direction from nearest town or city street address of well if located within city?  
 3 MILES EAST, 5 MILES NORTH OF MULLINVILLE

2 WATER WELL OWNER: HEFT & SONS Board of Agriculture, Division of Water Resources  
 RR#, St. Address, Box #: 14081 I STREET Application Number:  
 City, State, ZIP code: GREENSBURG, KS 67054-

3 LOCATE WELL'S LOCATION WITH AN "X" IN SECTION BOX:

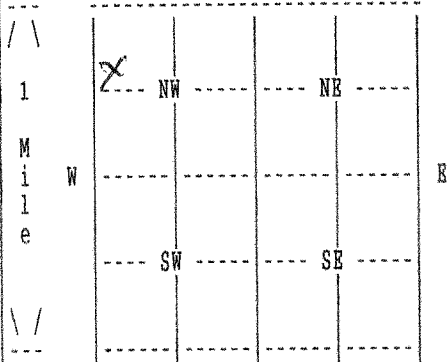

4 DEPTH OF COMPLETED WELL 75 ELEVATION: 0  
 Depth(s) Groundwater Encountered 1. 0 ft. 2. 0 ft. 3. 0 ft.

WELL'S STATIC WATER LEVEL 77 ft. below land surface measured on mo/day/yr 04/30/11  
 Pump test data: Well water was 0 ft. after 0 hours pumping 0 gpm

Estimated Yield 0 gpm: Well water was 0 ft. after 0 hours pumping 0 gpm

Bore Hole Diameter in. to 0 ft., and in. to 0 ft.

WELL WATER WAS: LIVESTOCK

Was a chemical/bacteriological sample submitted to department? No;  
 If yes, mo/day/yr sample was submitted Water well disinfected? Yes

5 TYPE OF BLANK CASING USED: PVC CASING JOINTS: GLURD  
 Blank casing diameter 4 in. to 65 ft., Dia in. to 0 ft., Dia in. to 0 ft.  
 Casing height above land surface -36 in., weight 0 lbs/ft. Wall thickness or gauge No. 26  
 TYPE OF SCREEN OR PERFORATION MATERIAL: PVC  
 SCREEN OR PERFORATION OPENINGS ARE: SAW CUT

SCREEN PERFORATED INTERVALS: From 65 ft. to 75 ft., From 0 ft. to 0 ft.  
 From 0 ft. to 0 ft., From 0 ft. to 0 ft.  
 GRAVEL PACK INTERVALS: From 0 ft. to 0 ft., From 0 ft. to 0 ft.  
 From 0 ft. to 0 ft., From 0 ft. to 0 ft.

6 GROUT MATERIAL NEAT CEMENT  
 Grout Intervals: From 0 ft. to 0 ft., From 0 ft. to 0 ft., From 0 ft. to 0 ft.  
 What is the nearest source of possible contamination: SEPTIC TANK How many feet? 5500  
 Direction from well? SOUTHWEST

FROM	TO	LITHOLOGIC LOG	FROM	TO	PLUGGING INTERVALS
			75	70	BENTONITE
			70	10	CLAY
			10	3	BENTONITE
			0	0	
			0	0	
			0	0	
			0	0	
			0	0	
			0	0	
			0	0	

7 CONTRACTOR'S OR LANDOWNER'S CERTIFICATION: This water well was Plugged under my jurisdiction and was completed on (mo/day/year) 04/30/11 and this record is true to the best of my knowledge and belief. Kansas Water Well Contractor's License No. 653 This Water Well Record was completed on (mo/day/yr) 06/25/11 under the business name of DAN HAYSE WATER WELL SERV by (signature) Dan Hayse