

WATER WELL RECORD

Form WWC-5


Division of Water Resources App. No.

1 LOCATION OF WATER WELL: County: Kiowa Fraction: 1/4 NC 1/4 SW 1/4 Section Number: 1 Township No.: T 27 S Range Number: R 19 E W

Street/Rural Address of Well Location; if unknown, distance & direction from nearest town or intersection: Approximately 8 miles north and 3 miles west of Greensburg.

2 WATER WELL OWNER: Roger Stotts RR#, Street Address, Box #: 22259 Hwy 183 City, State, ZIP Code : Greensburg, KS 67054

Global Positioning System (GPS) information: Latitude: 37.722801 Longitude: -99.354487 Elevation: unknown Datum: WGS 84, NAD 83, NAD 27 Collection Method: GPS unit (Make/Model: WAAS)

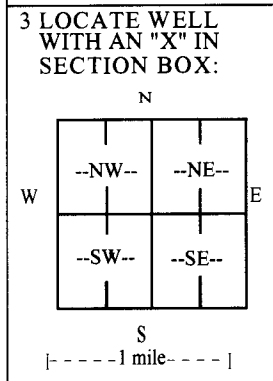

4 DEPTH OF COMPLETED WELL: 174 ft. Depth(s) Groundwater Encountered (1) 66.50 ft. (2) ft. (3) ft. WELL'S STATIC WATER LEVEL 66.50 ft. below land surface measured on mo/day/yr 3/6/12

5 TYPE OF CASING USED: Steel, PVC, Other CASING JOINTS: Glued, Clamped, Welded, Threaded Casing diameter 16 in. to 126 ft., Diameter 16 in. to 138 ft., Diameter in. to ft. Casing height above land surface 7 in., Weight 19.75 lbs./ft., Wall thickness or gauge No. .616

6 GROUT MATERIAL: Neat cement, Cement grout, Bentonite, Other Grout Intervals: From ft. to ft., From 3 ft. to 23 ft., From ft. to ft. What is the nearest source of possible contamination: Septic tank, Lateral lines, Pit privy, Livestock pens, Insecticide storage, Other (specify below)

Table with 6 columns: FROM, TO, LITHOLOGIC LOG, FROM, TO, LITHO. LOG (cont.) or PLUGGING INTERVALS. Rows describe geological layers from 0 to 174 feet depth.

7 CONTRACTOR'S OR LANDOWNER'S CERTIFICATION: This water well was constructed, reconstructed, or plugged under my jurisdiction and was completed on (mo/day/year) 3/6/12 and this record is true to the best of my knowledge and belief.

INSTRUCTIONS: Use typewriter or ball point pen. PLEASE PRESS FIRMLY and PRINT clearly. Please fill in blanks and check the correct answers. Send three copies (white, blue, pink) to Kansas Department of Health and Environment, Bureau of Water, Geology Section, 1000 SW Jackson St., Suite 420, Topeka, Kansas 66612-1367.