


264

1 LOCATION OF WATER WELL: Fraction Section Number Township Number Range Number  
 COUNTY: KIOWA SE 1/4 NE 1/4 SE 1/4 26 T 27 S R 19 W

Distance and direction from nearest town or city street address of well if located within city?  
 2 MILES NORTH, 2.5 WEST, 1 NORTH, 1 WEST OF GREENSBURG

2 WATER WELL OWNER: TGT PETROLEUM CORP.  
 RR#, St. Address, Box #: PO BOX 75097 Board of Agriculture, Division of Water Resources  
 City, State, ZIP code: WICHITA, KS 67275-0097 Application Number: 20050374

3 LOCATE WELL'S LOCATION WITH AN "X" IN SECTION BOX:

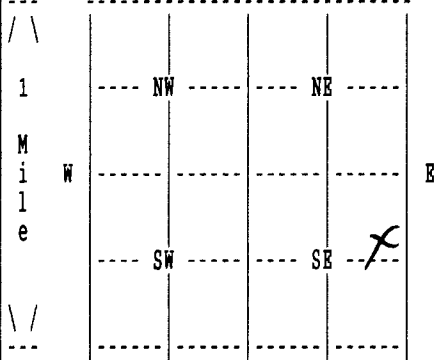

4 DEPTH OF COMPLETED WELL 140 ELEVATION: 0  
 Depth(s) Groundwater Encountered 1. 0 ft. 2. 0 ft. 3. 0 ft.

WELL'S STATIC WATER LEVEL 68 ft. below land surface measured on mo/day/yr 12/29/05  
 Pump test data: Well water was 0 ft. after 0 hours pumping 0 gpm

Estimated Yield 0 gpm: Well water was 0 ft. after 0 hours pumping 0 gpm

Bore Hole Diameter 8.75 in. to 140 ft., and in. to 0 ft.

WELL WATER TO BE USED AS: OIL FIELD

Was a chemical/bacteriological sample submitted to department? No ;  
 If yes, mo/day/yr sample was submitted Water well disinfected? Yes

5 TYPE OF BLANK CASING USED: PVC CASING JOINTS: GLUED  
 Blank casing diameter 5 in. to 120 ft., Dia in. to 0 ft., Dia in. to 0 ft.  
 Casing height above land surface 12 in., weight 0 lbs/ft. Wall thickness or gauge No. 26  
 TYPE OF SCREEN OR PERFORATION MATERIAL: PVC  
 SCREEN OR PERFORATION OPENINGS ARE: SAW CUT

SCREEN PERFORATED INTERVALS: From 120 ft. to 140 ft., From 0 ft. to 0 ft.  
 From 0 ft. to 0 ft., From 0 ft. to 0 ft.  
 GRAVEL PACK INTERVALS: From 25 ft. to 140 ft., From 0 ft. to 0 ft.  
 From 0 ft. to 0 ft., From 0 ft. to 0 ft.

6 GROUT MATERIAL BENTONITE  
 Grout Intervals: From 2 ft. to 25 ft., From 0 ft. to 0 ft., From 0 ft. to 0 ft.  
 What is the nearest source of possible contamination: OIL/GAS WELL  
 Direction from well? SOUTHWEST How many feet? 1500

| FROM | TO  | LITHOLOGIC LOG  | FROM | TO | PLUGGING INTERVALS |
|------|-----|-----------------|------|----|--------------------|
| 0    | 8   | SILT AND SAND   |      |    |                    |
| 8    | 28  | TAN CLAY        |      |    |                    |
| 28   | 35  | SAND AND GRAVEL |      |    |                    |
| 35   | 42  | TAN CLAY        |      |    |                    |
| 42   | 62  | SAND AND GRAVEL |      |    |                    |
| 62   | 67  | TAN CLAY        |      |    |                    |
| 67   | 103 | SAND AND GRAVEL |      |    |                    |
| 103  | 114 | TAN CLAY        |      |    |                    |
| 114  | 140 | SAND AND GRAVEL |      |    |                    |

7 CONTRACTOR'S OR LANDOWNER'S CERTIFICATION: This water well was Constructed under my jurisdiction and was completed on (mo/day/year) 12/29/05 and this record is true to the best of my knowledge and belief. Kansas Water Well Contractor's License No. 653 This Water Well Record was completed on (mo/day/yr) 12/31/05 under the business name of DAN HAYSE WATER WELL SERV by (signature) Dan Hayse