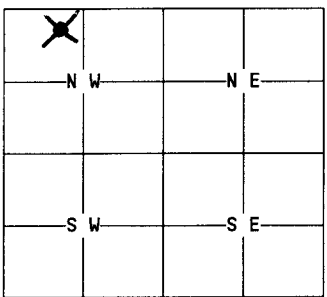


1	LOCATION OF WATER WELL: County: Sedgwick	Fraction NE 1/4 NW 1/4 NW 1/4	Section Number 26	Township Number 27	Range Number 2 W																					
Distance and direction from nearest town or city street address of well if located within city? 1 mile North and 3 1/4 Miles East of Goddard, KS																										
2	WATER WELL OWNER: Richard & Donna Savina RR#, St. Address, Box #: 14901 Maple City, State, ZIP Code : Wichita, KS 67200 Board of Agriculture, Division of Water Resources Application Number:																									
3	MARK WELL'S LOCATION WITH AN "X" IN SECTION BOX: N  S W E																									
4	DEPTH OF WELL..... 150ft. WELL'S STATIC WATER LEVEL.....ft. WELL WAS USED AS: 1 Domestic 5 Public Water Supply 9 Dewatering 2 Irrigation 6 Oil Field Water Supply 10 Monitoring Well 3 Feedlot 7 Lawn and Garden Only 11 Injection Well 4 Industrial 8 Air Conditioning X 2 Other. Heat. Pump..... 6 @ 150 ft. Was a chemical/bacteriological sample submitted to Department? Yes....No X .. If yes, mo/day/yr sample was submitted..... Water Well Disinfected: Yes..... No.. X ...																									
5	TYPE OF BLANK CASING USED: 1 Steel 3 RMP (SR) 5 Wrought 7 Fiberglass X Other (specify below) 2 PVC 4 ABS 6 Asbestos-Cement 8 Concrete Tile ..Polyethylene..... Blank casing diameter... 3/4 ...in. Was casing pulled? Yes..... No..... If yes, how much..... Casing height above or below land surface.....in.																									
6	GROUT PLUG MATERIAL: 1 Neat cement 2 Cement grout X Bentonite 4 Other..... Grout Plug Intervals: From.. 0 ...ft. to.. 150 ...ft., From.....ft. toft., From..... to.....ft. What is the nearest source of possible contamination: 1 Septic tank 6 Seepage pit 11 Fuel storage 16 Other (specify below) 2 Sewer lines 7 Pit privy 12 Fertilizer storage X Watertight sewer lines 8 Sewage lagoon 13 Insecticide storage 14 Abandoned water well 4 Lateral lines 9 Feedyard 15 Oil well/Gas well 5 Cess Pool 10 Livestock pens Direction from well? ... East How many feet? 80 ft.																									
<table border="1" style="width:100%; border-collapse: collapse;"> <thead> <tr> <th style="width:10%;">FROM</th> <th style="width:10%;">TO</th> <th style="width:80%;">PLUGGING MATERIALS</th> </tr> </thead> <tbody> <tr> <td>0</td> <td>2</td> <td>Top Soil</td> </tr> <tr> <td>2</td> <td>13</td> <td>Tan Clay</td> </tr> <tr> <td>13</td> <td>22</td> <td>Gray Clay with Fine Sand</td> </tr> <tr> <td>22</td> <td>31</td> <td>Fine Sand</td> </tr> <tr> <td>31</td> <td>46</td> <td>Green Shale</td> </tr> <tr> <td>46</td> <td>96</td> <td>Gray Shale</td> </tr> </tbody> </table> Heat Pump Construction 96 108 Red Shale 108 150 Gray Shale						FROM	TO	PLUGGING MATERIALS	0	2	Top Soil	2	13	Tan Clay	13	22	Gray Clay with Fine Sand	22	31	Fine Sand	31	46	Green Shale	46	96	Gray Shale
FROM	TO	PLUGGING MATERIALS																								
0	2	Top Soil																								
2	13	Tan Clay																								
13	22	Gray Clay with Fine Sand																								
22	31	Fine Sand																								
31	46	Green Shale																								
46	96	Gray Shale																								
7	CONTRACTOR'S OR LANDOWNER'S CERTIFICATION: This water well was plugged under my jurisdiction and was completed on (mo/day/year).... 12-11-95 and this record is true to the best of my knowledge and belief. Kansas Water Well Contractor's License No. 138 This Water Well Record was completed on (mo/day/year) 1-1-96 by (signature) Mike Peterson under the business name of Peterson Irrigation, Inc.																									
INSTRUCTIONS: Use typewriter or ball point pen. Please press firmly and print clearly. Please fill in blanks, underline or circle the correct answers. Send top three copies to Kansas Department of Health and Environment, Bureau of Water, Topeka, Kansas 66620-0001. Telephone: 913/296-3565. Send one to Water Well Owner and retain one for your records.																										