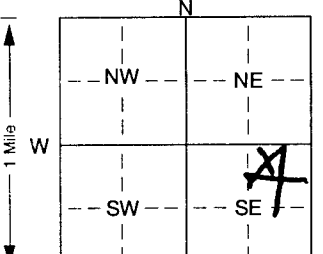


KSA 82a-1212 ID No.

1 LOCATION OF WATER WELL: Fraction NW 1/4 NE 1/4 SE 1/4		Section Number 24		Township Number T 27 S		Range Number R 2 EW	
County: Sedgewick Distance and direction from nearest town or city street address of well if located within city? 12022 Meribean Ct							
2 WATER WELL OWNER: Mr. Stute							
RR#, St. Address, Box #: 12022 Meribean City, State, ZIP Code: Wichita, KS 67235 Board of Agriculture, Division of Water Resources Application Number: none							
3 LOCATE WELL'S LOCATION WITH AN "X" IN SECTION BOX:		4 DEPTH OF COMPLETED WELL: 51 ft. ELEVATION: 1300					
		Depth(s) Groundwater Encountered 1. 31 ft. 2. ft. 3. ft. WELL'S STATIC WATER LEVEL 31 ft. below land surface measured on mo/day/yr 3-23-01					
Pump test data: Well water was ft. after hours pumping gpm Est. Yield gpm Well water was ft. after hours pumping gpm Bore Hole Diameter 9 in. to 31 ft. and in. to ft. WELL WATER TO BE USED AS: 5 Public water supply 8 Air conditioning 11 Injection well 1 Domestic 3 Feedlot 6 Oil field water supply 9 Dewatering 12 Other (Specify below) 2 Irrigation 4 Industrial 7 Domestic (lawn & garden) 10 Monitoring well							
Was a chemical/bacteriological sample submitted to Department? Yes. No. X; If yes, mo/day/yr sample was submitted Water Well Disinfected? Yes X No X							
5 TYPE OF BLANK CASING USED: 1 Steel 3 RMP (SR) 6 Asbestos-Cement 9 Other (specify below) Welded 2 PVC 4 ABS 7 Fiberglass Threaded Blank casing diameter 5 in. to 41 ft. Dia in. to ft. Dia in. to ft. Casing height above land surface 12 in., weight lbs./ft. Wall thickness or gauge No. 160							
TYPE OF SCREEN OR PERFORATION MATERIAL: 1 Steel 3 Stainless steel 5 Fiberglass 8 RMP (SR) 10 Asbestos-cement 2 Brass 4 Galvanized steel 6 Concrete tile 9 ABS 11 Other (specify) 12 None used (open hole)							
SCREEN OR PERFORATION OPENINGS ARE: 1 Continuous slot 3 Mill slot 5 Gauzed wrapped 8 Saw cut 11 None (open hole) 2 Louvered shutter 4 Key punched 6 Wire wrapped 9 Drilled holes 10 Other (specify) ft.							
SCREEN-PERFORATED INTERVALS: From 41 ft. to 52 ft. From ft. to ft. From ft. to ft. GRAVEL PACK INTERVALS: From ft. to ft. From ft. to ft. From ft. to ft.							
6 GROUT MATERIAL: 1 Neat cement 2 Cement grout 3 Bentonite 4 Other Grout Intervals: From 0 ft. to 20 ft. From ft. to ft. From ft. to ft. What is the nearest source of possible contamination: 1 Septic tank 4 Lateral lines 7 Pit privy 10 Livestock pens 14 Abandoned water well 2 Sewer lines 5 Cess pool 8 Sewage lagoon 11 Fuel storage 15 Oil well/Gas well 3 Watertight sewer lines 6 Seepage pit 9 Feedyard 12 Fertilizer storage 16 Other (specify below) 13 Insecticide storage							
Direction from well? north How many feet? 30							
FROM TO LITHOLOGIC LOG		FROM TO PLUGGING INTERVALS					
0 15		Top Soil Band					
15 39		Fine Tan Sand					
39 51		Coarse Tan Sand					
7 CONTRACTOR'S OR LANDOWNER'S CERTIFICATION: This water well was (1) constructed, (2) reconstructed, or (3) plugged under my jurisdiction and was completed on (mo/day/year) 3-23-01 and this record is true to the best of my knowledge and belief. Kansas Water Well Contractor's Licence No. 472 This Water Well Record was completed on (mo/day/yr) 3-23-01 under the business name of Beardon Pumps & Wells by (signature) David Beard							
INSTRUCTIONS: Use typewriter or ball point pen. PLEASE PRESS FIRMLY and PRINT clearly. Please fill in blanks, underline or circle the correct answers. Send top three copies to Kansas Department of Health and Environment, Bureau of Water, Topeka, Kansas 66620-0001. Telephone 785-296-5524. Send one to WATER WELL OWNER and retain one for your records. Fee of \$5.00 for each constructed well.							