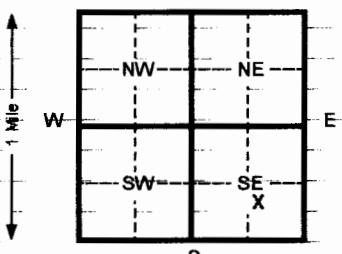


1 LOCATION OF WATER WELL:		Fraction	Section Number	Township Number	Range Number
County: SEDGWICK		NW ¼ NE ¼ SE ¼	20 28	T 27S S	R 2W E/W
Distance and direction from nearest town or city street address of well if located within city?					
2122 ST. ANDREWS CT.; GODDARD, KS					
2 WATER WELL OWNER: MARK FURNISH					
RR#, St. Address, Box #			Board of Agriculture, Division of Water Resources		
2122 ST. ANDREWS CT.			Application Number:		
City, State, ZIP Code			GODDARD, KS		
3 LOCATE WELL'S LOCATION WITH AN "X" IN SECTION BOX:		4 DEPTH OF COMPLETED WELL			
		80 ft. ELEVATION:			
		Depth(s) Groundwater Encountered 1 40 ft. 2 ft. 3 ft.			
		WELL'S STATIC WATER LEVEL 40 ft. below land surface measured on mo/day/yr 9-2-03			
		Pump test data: Well water was ft. after hours pumping gpm			
		Est. Yield gpm: Well water was ft. after hours pumping gpm			
		Bore Hole Diameter 10 in. to 80 ft. and in. to ft.			
		WELL WATER TO BE USED AS: 5 Public water supply 8 Air conditioning 11 Injection well			
		1 Domestic 3 Feed lot 6 Oil field water supply 9 Dewatering 12 Other (Specify below)			
		2 Irrigation 4 Industrial 7 Lawn and garden (domestic) 10 Monitoring well			
		Was a chemical/bacteriological sample submitted to Department? Yes No X If yes, mo/day/yr sample was submitted			
		Water Well Disinfected? Yes X No			
5 TYPE OF CASING USED:		CASING JOINTS: Glued X Clamped			
1 Steel 3 RMP (SR) 5 Wrought Iron 8 Concrete tile		Welded			
2 PVC 4 ABS 6 Asbestos-Cement 9 Other (specify below)		Threaded			
7 Fiberglass					
Blank casing diameter 5 in. to 80 ft. Dia in. to ft. Dia in. to ft.					
Casing height above land surface 16 in. weight 160 lbs./ft. Wall thickness or gauge No. 26					
TYPE OF SCREEN OR PERFORATION MATERIAL:		7 PVC 10 Asbestos-cement			
1 Steel 3 Stainless steel 5 Fiberglass 8 RMP (SR) 11 Other (specify)					
2 Brass 4 Galvanized steel 6 Concrete tile 9 ABS 12 None used (open hole)					
SCREEN OR PERFORATION OPENINGS ARE:		5 Gauzed wrapped 8 Saw cut 11 None (open hole)			
1 Continuous slot 3 Mill slot 6 Wire wrapped 9 Drilled holes					
2 Louvered shutter 4 Key punched 7 Torch cut 10 Other (specify)					
SCREEN-PERFORATED INTERVALS: From 60 ft. to 80 ft. From ft. to ft.					
GRAVEL PACK INTERVALS: From 24 ft. to 80 ft. From ft. to ft.					
From ft. to ft. From ft. to ft.					
6 GROUT MATERIAL: 1 Neat cement 2 Cement grout 3 Bentonite 4 Other					
Grout Intervals From 4 ft. to 24 ft. From ft. to ft. From ft. to ft.					
What is the nearest source of possible contamination:		10 Livestock pens 14 Abandoned water well			
1 Septic tank 4 Lateral lines 7 Pit privy 11 Fuel storage 15 Oil well/ Gas well					
2 Sewer lines 5 Cess pool 8 Sewage lagoon 12 Fertilizer storage 16 Other (specify below)					
3 Watertight sewer lines 6 Seepage pit 9 Feedyard 13 Insecticide storage					
Direction from well? EAST		How many feet? 40			
FROM TO CODE LITHOLOGIC LOG FROM TO PLUGGING INTERVALS					
0 3 TOPSOIL					
3 24 CLAY					
24 37 GREEN SHALE					
37 40 BLUE SHALE					
40 65 RED SHALE					
65 80 BLUE SHALE					
7 CONTRACTOR'S OR LANDOWNER'S CERTIFICATION: This water well was (1) constructed, (2) reconstructed, or (3) plugged under my jurisdiction and was completed on (mo/day/yr) 9-2-03 and this record is true to the best of my knowledge and belief. Kansas					
Water Well Contractor's License No. 611 This Water Well Record was completed on (mo/day/yr) 9-2-03					
under the business name of Chase Drilling by (signature) RICK CHASE					
INSTRUCTIONS: Please fill in blanks and circle the correct answers. Send three copies to Kansas Department of Health and Environment, Bureau of Water, 1000 S W Jackson St., Ste. 420, Topeka, Kansas 66612-1367. Telephone: 913-296-5545. Send one to WATER WELL OWNER and retain one for your records.					

OFFICE USE ONLY

—

२

SEC