WATER WELL RECORD Form WWC-5 KSA 82a-1212 ID No. _____

1 LOCATION OF WATER WELL: County: Sedgwick	Fraction: NE ¼ SW ¼ NW ¼	Section Number: 28	Township Number: T 27 S	Range Number: R 2 E (W)

Distance and direction from nearest town or city street address of well if located within city? 2514 St. Andrews.

2 WATER WELL OWNER: Water Reed

RR#, St. Address, Box # : 2427 Grant

City, State, ZIP Code : Wichita, Ks. 67213

Board of Agriculture, Division of Water Resources Application Number:

3 LOCATE WELL'S LOCATION WITH AN "X" IN SECTION BOX:

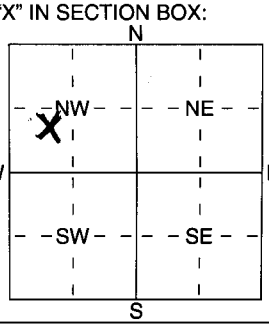

4 DEPTH OF COMPLETED WELL 66 ft. ELEVATION: .....

Depth(s) Groundwater Encountered 1 ..... ft. 2 ..... ft. 3 ..... ft.

WELL'S STATIC WATER LEVEL 23 ft. below land surface measured on mo/day/yr .....

Pump test data: Well water was ..... ft. after ..... hours pumping ..... gpm

Est. Yield 18 gpm: Well water was ..... ft. after ..... hours pumping ..... gpm

WELL WATER TO BE USED AS: 1 Domestic 2 Irrigation 3 Feedlot 4 Industrial 5 Public water supply 6 Oil field water supply (7) Domestic (lawn & garden) 8 Air conditioning 9 Dewatering 10 Monitoring well 11 Injection well 12 Other (Specify below)

Was a chemical/bacteriological sample submitted to Department? Yes ..... No X ; If yes, mo/day/yrs sample was submitted

Water Well Disinfected? Yes X No

5 TYPE OF BLANK CASING USED: 1 Steel (2) PVC 3 RMP (SR) 4 ABS 5 Wrought iron 6 Asbestos-Cement 7 Fiberglass 8 Concrete tile 9 Other (specify below)

CASING JOINTS: Glued X Clamped ..... Welded ..... Threaded .....

Blank casing diameter 5" in. to 25 ft., Dia ..... in. to ..... ft., Dia ..... in. to ..... ft.

Casing height above land surface 14" in., weight 2.14 lbs./ft. Wall thickness or guage No. 160 PSI

TYPE OF SCREEN OR PERFORATION MATERIAL: 1 Steel 2 Brass 3 Stainless Steel 4 Galvanized Steel 5 Fiberglass 6 Concrete tile (7) PVC 8 RMP (SR) 9 ABS 10 Asbestos-Cement 11 Other (Specify) ..... 12 None used (open hole)

SCREEN OR PERFORATION OPENINGS ARE: 1 Continuous slot 2 Louvered shutter (3) Mill slot 4 Key punched 5 Guazed wrapped 6 Wire wrapped 7 Torch cut 8 Saw cut 9 Drilled holes 10 Other (specify) ..... 11 None (open hole)

SCREEN-PERFORATED INTERVALS: From 40 ft. to 66 ft., From ..... ft. to ..... ft.
From ..... ft. to ..... ft., From ..... ft. to ..... ft.

GRAVEL PACK INTERVALS: From 25 ft. to 66 ft., From ..... ft. to ..... ft.
From ..... ft. to ..... ft., From ..... ft. to ..... ft.

6 GROUT MATERIAL: 1 Neat cement 2 Cement grout (3) Bentonite 4 Other .....

Grout Intervals: From 3 ft. to 25 ft., From ..... ft. to ..... ft., From ..... ft. to ..... ft.

What is the nearest source of possible contamination: 1 Septic tank 2 Sewer lines (3) Watertight sewer lines 4 Lateral lines 5 Cess pool 6 Seepage pit 7 Pit privy 8 Sewage lagoon 9 Feedyard 10 Livestock pens 11 Fuel storage 12 Fertilizer storage 13 Insecticide storage 14 Abandoned water well 15 Oil well/Gas well 16 Other (specify below) .....

Direction from well? East How many feet? 12

FROM	TO	LITHOLOGIC LOG	FROM	TO	PLUGGING INTERVALS
0	3	Top Soil			
3	21	Clay			
21	35	Fine Sand			
35	66	Blue Shale			

7 CONTRACTOR'S OR LANDOWNER'S CERTIFICATION: This water well was (1) constructed, (2) reconstructed, or (3) plugged under my jurisdiction and was completed on (mo/day/year) 5-3-05 and this record is true to the best of my knowledge and belief. Kansas Water Well Contractor's Licence No #740 This Water Well Record was completed on (mo/day/yr) 5-5-05 under the business name of Wenzel Drilling Inc. by (signature) [signature]

INSTRUCTIONS: Use typewriter or ball point pen. *PLEASE PRESS FIRMLY* and *PRINT* clearly. Please fill in blanks, underline or circle the correct answers. Send top three copies to Kansas Department of Health and Environment, Bureau of Water, Geology Section, 1000 SW Jackson St., Suite 420, Topeka, Kansas 66612-1367. Telephone 785-296-5522. Send one to WATER WELL OWNER and retain one for your records. Fee of $5.00 for each constructed well.