

1 LOCATION OF WATER WELL:	Fraction	Section Number	Township Number	Range Number
County: <u>Sedgewick</u>	<u>NE 1/4 NW 1/4 SE 1/4</u>	<u>27</u>	T <u>27</u> S	R <u>2</u> E <u>W</u>

Distance and direction from nearest town or city street address of well if located within city?

507 S. Reece Circle, Goddard, Ks.2 WATER WELL OWNER: Keith Morris

RR#, St. Address, Box #

City, State, ZIP Code


507 Reece Circle Wichita KS

Board of Agriculture, Division of Water Resources

Application Number:

3 LOCATE WELL'S LOCATION WITH 4 DEPTH OF COMPLETED WELL 9.5 ft. ELEVATION:

AN "X" IN SECTION BOX:

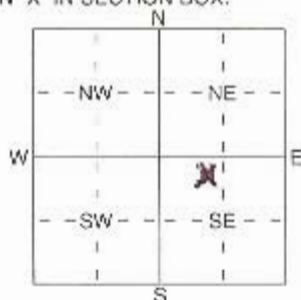

Depth(s) Groundwater Encountered _____ ft. 2 _____ ft. 3 _____ ft.

WELL'S STATIC WATER LEVEL 30.25 ft. below land surface measured on mo/day/yr _____

Pump test data: Well water was _____ ft. after _____ hours pumping _____ gpm

Est. Yield 20 gpm; Well water was _____ ft. after _____ hours pumping _____ gpm

WELL WATER TO BE USED AS: 5 Public water supply 8 Air conditioning 11 Injection well

1 Domestic 3 Feedlot 6 Oil field water supply 9 Dewatering 12 Other (Specify below)

2 Irrigation 4 Industrial 6 Domestic (lawn & garden) 10 Monitoring well _____Was a chemical/bacteriological sample submitted to Department? Yes _____ No X; If yes, mo/day/yr sample was sub-mitted Water Well Disinfected? Yes No

5 TYPE OF BLANK CASING USED:

5 Wrought iron

8 Concrete tile

CASING JOINTS: Glued X Clamped _____

1 Steel

3 RMP (SR)

6 Asbestos-Cement

9 Other (specify below)

Welded _____

2 PVC

4 ABS

7 Fiberglass

Threaded _____

Blank casing diameter _____ in. to _____ ft. Dia _____ in. to _____ ft. Dia _____ in. to _____ ft.

Casing height above land surface _____ in. weight _____ lbs./ft. Wall thickness or gauge No. 16.0 P.S.T.

TYPE OF SCREEN OR PERFORATION MATERIAL:

1 Steel

3 Stainless Steel

5 Fiberglass

6 PVC

10 Asbestos-Cement

2 Brass

4 Galvanized Steel

6 Concrete tile

8 RMP (SR)

11 Other (Specify) _____

12 None used (open hole)

SCREEN OR PERFORATION OPENINGS ARE:

1 Continuous slot

3 Mill slot

5 Gauzed wrapped

8 Saw cut

11 None (open hole)

2 Louvered shutter

4 Key punched

6 Wire wrapped

9 Drilled holes

7 Torch cut

10 Other (specify) _____ ft.

SCREEN-PERFORATED INTERVALS: From _____ ft. to _____ ft. From _____ ft. to _____ ft.

GRAVEL PACK INTERVALS: From _____ ft. to _____ ft. From _____ ft. to _____ ft.

From _____ ft. to _____ ft. From _____ ft. to _____ ft.

From _____ ft. to _____ ft. From _____ ft. to _____ ft.

6 GROUT MATERIAL: 1 Neat cement 2 Cement grout 3 Bentonite 4 Other _____

Grout intervals: From _____ ft. to _____ ft. From _____ ft. to _____ ft. From _____ ft. to _____ ft.

What is the nearest source of possible contamination:

1 Septic tank

4 Lateral lines

7 Pit privy

10 Livestock pens

14 Abandoned water well

2 Sewer lines

5 Cess pool

8 Sewage lagoon

11 Fuel storage

15 Oil well/Gas well

3 Watertight sewer lines

6 Seepage pit

9 Feedyard

12 Fertilizer storage

16 Other (specify below)

Direction from well? SHow many feet? 100'

FROM TO LITHOLOGIC LOG FROM TO PLUGGING INTERVALS

0 1T.S.1 15CLAY15 95SHALE7 CONTRACTOR'S OR LANDOWNER'S CERTIFICATION: This water well was (1) constructed, (2) reconstructed, or (3) plugged under my jurisdiction and was completed on (mo/day/year) 5-12-03 and this record is true to the best of my knowledge and belief. KansasWater Well Contractor's Licence No 740 This Water Well Record was completed on (mo/day/yr) 5-12-03under the business name of WENNER DRILLING INC by (signature) [Signature]