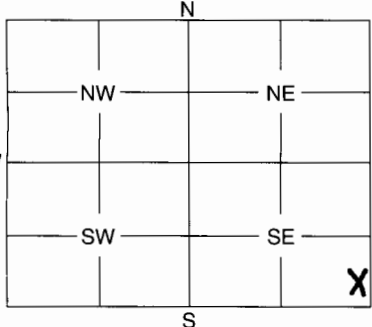


| 1   | LOCATION OF WATER WELL:<br>County: <b>Sedgwick</b>   | Fraction<br><b>SE</b><br>$\frac{1}{4}$ $\frac{1}{4}$ $\frac{1}{4}$ | Section Number<br><b>21</b> <del>27</del>   | Township Number<br><b>27</b> <b>5</b>          | Range Number<br><b>2</b> <b>W</b> <sub>E/W</sub> |                                                   |                       
|---|---|--------------------------------------------------------------------|---|------------------------------------------------|--------------------------------------------------|---------------------------------------------------|-----------------------|--------------------|---------------------------------------|--------------------------|--------------------|------------------------------------|----------------------------|--------------------------|------------------------------------------------|------------------------|----------------|-----------------|------------|-------------------------|--|-------------|-------------------|----------------------|--|--|--|--|--|--|--|--|
| Distance and direction from nearest town or city street address of well if located within city?<br><b>259 S, 167th West</b>   |   |                                                                    
| 2   | WATER WELL OWNER: <b>Kenneth Wewe</b><br>RR #, St. Address, Box #: <b>1421 N. Parkridge</b><br>City, State, ZIP Code: <b>Wichita 67212</b><br>Board of Agriculture, Division of Water Resources<br>Application Number: _____   |                                                                    |   
| 3   | MARK WELL'S LOCATION WITH AN "X" IN SECTION BOX:<br><div style="text-align:center"></div>   |                                                                    | 4 DEPTH OF WELL ..... <b>40</b> ..... ft.<br>WELL'S STATIC WATER LEVEL ..... <b>32</b> ..... ft.<br>WELL WAS USED AS:<br><table style="width:100%"><tr><td><input checked="" type="checkbox"/> 1 Domestic</td><td>5 Public Water Supply</td><td>9 Dewatering</td></tr><tr><td><input type="checkbox"/> 2 Irrigation</td><td>6 Oil Field Water Supply</td><td>10 Monitoring Well</td></tr><tr><td><input type="checkbox"/> 3 Feedlot</td><td>7 Domestic (Lawn &amp; Garden)</td><td>11 Injection Well</td></tr><tr><td><input type="checkbox"/> 4 Industrial</td><td>8 Air Conditioning</td><td>12 Other .....</td></tr></table><br>Was a chemical / bacteriological sample submitted to Department? Yes ..... No <input checked="" type="checkbox"/> <b>X</b><br>If yes, mo/day/yr sample was submitted .....<br>Water Well Disinfected: Yes <input checked="" type="checkbox"/> <b>X</b> No .




| 5   | TYPE OF BLANK CASING USED:<br><table style="width:100%"><tr><td>1 Steel</td><td>3 RMP (SR)</td><td>5 Wrought</td><td>7 Fiberglass</td><td>9 Other (Specify below)</td></tr><tr><td>2 PVC</td><td>4 ABS</td><td>6 Asbestos-Cement</td><td>8 Concrete Tile</td><td>..... <b>hand dug well w/ brick wall</b> .....</td></tr></table><br>Blank casing diameter ..... <b>42</b> ..... in.   Was casing pulled?   Yes ..... No <input checked="" type="checkbox"/> <b>X</b> If yes, how much .....<br>Casing height above or below land surface ..... <b>even</b> ..... in.   |                                                                    |   |                                                |                                                  | 


| 6   | GROUT PLUG MATERIAL:   1 Neat cement <input checked="" type="checkbox"/> <b>2 Cement grout</b> 3 Bentonite   4 Other .....<br>Grout Plug Intervals:   From ..... <b>8</b> ..... ft.   to ..... <b>7</b> ..... ft.,   From ..... ft.   to ..... ft.,   From ..... to ..... ft.<br>What is the nearest source of possible contamination:<br><table style="width:100%"><tr><td><input checked="" type="checkbox"/> 1 Septic tank</td><td>6 Seepage pit</td><td>11 Fuel storage</td><td>16 Other (specify below)</td></tr><tr><td>2 Sewer lines</td><td>7 Pit privy</td><td>12 Fertilizer storage</td><td>.....</td></tr><tr><td>3 Watertight sewer lines</td><td>8 Sewage lagoon</td><td>13 Insecticide storage</td><td></td></tr><tr><td>4 Lateral lines</td><td>9 Feedyard</td><td>14 Abandoned water well</td><td></td></tr><tr><td>5 Cess pool</td><td>10 Livestock pens</td><td>15 Oil well/Gas well</td><td></td></tr></table><br>Direction from well? ..... <b>South</b> .....   How many feet? ..... <b>65</b> ..... |                                                                    |   |                                                |                                                  





| <table border="1" style="width:100%"><thead><tr><th style="width:15%">FROM</th><th style="width:15%">TO</th><th style="width:70%">PLUGGING MATERIALS</th></tr></thead><tbody><tr><td> </td><td> </td><td> </td></tr><tr><td> </td><td> </td><td> </td></tr><tr><td> </td><td> </td><td> </td></tr><tr><td> </td><td> </td><td> </td></tr><tr><td> </td><td> </td><td> </td></tr><tr><td> </td><td> </td><td> </td></tr><tr><td> </td><td> </td><td> </td></tr><tr><td> </td><td> </td><td> </td></tr></tbody></table> <div style="margin-top: 20px; text-align: right; font-size: 1.2em;">Work was done by<br/>owner - Kenneth<br/>Wewe</div> |   |                                                                    |   |                                                |                                                  | FROM                                              | TO                    | PLUGGING MATERIALS |                                       |                          
| FROM   | TO   | PLUGGING MATERIALS                                                 |   |                                                
|   |   
| 7   | CONTRACTOR'S OF LANDOWNER'S CERTIFICATION: This water well was plugged under my jurisdiction and was completed on (mo/day/year) ..... <b>Jan 17, 2006</b> ..... and this record is true to the best of my knowledge and belief. Kansas Water Well Contractor's License No. .... This Water Well Record was completed on (mo/day/year) ..... under the business name of .....<br>by (signature) .....   |                                                                    |   
| INSTRUCTIONS: Use typewriter or ball point pen. Please press firmly and print clearly. Please fill in blanks, underline or circle the correct answers. Send top three copies to Kansas Department of Health and Environment, Bureau of Water, Geology Section, 1000 SW Jackson St., Ste. 420, Topeka, Kansas 66612-1367. Telephone: 785/296-5522. Send one to Water Well Owner and retain one for your records.   |   |                                                                    