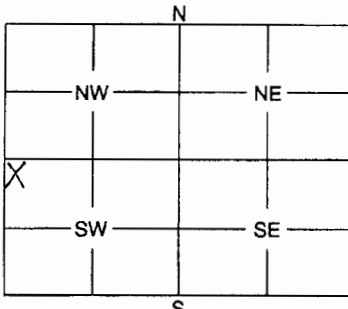


1	LOCATION OF WATER WELL:	Fraction	Section Number	Township Number	Range Number
County: Sedgwick		NW $\frac{1}{4}$ NW $\frac{1}{4}$ SW $\frac{1}{4}$	20	27	2 EW

Distance and direction from nearest town or city street address of well if located within city?
102 S. Rock Road, Wichita

2	WATER WELL OWNER: Total Petrochemical, Inc. 1201 Louisiana Street RR #, St. Address, Box #: Houston, TX 77002 City, State, ZIP Code :		Board of Agriculture, Division of Water Resources Application Number:
---	--	--	--

3	MARK WELL'S LOCATION WITH AN "X" IN SECTION BOX: 	4	DEPTH OF WELL 23 ft. WELL'S STATIC WATER LEVEL Dry ft. WELL WAS USED AS: <table border="0"> <tr> <td>1 Domestic</td> <td>5 Public Water Supply</td> <td>9 Dewatering</td> </tr> <tr> <td>2 Irrigation</td> <td>6 Oil Field Water Supply</td> <td>● Monitoring Well</td> </tr> <tr> <td>3 Feedlot</td> <td>7 Domestic (Lawn & Garden)</td> <td>11 Injection Well</td> </tr> <tr> <td>4 Industrial</td> <td>8 Air Conditioning</td> <td>12 Other</td> </tr> </table> Was a chemical / bacteriological sample submitted to Department? Yes No If yes, mo/day/yr sample was submitted Water Well Disinfected: Yes No	1 Domestic	5 Public Water Supply	9 Dewatering	2 Irrigation	6 Oil Field Water Supply	● Monitoring Well	3 Feedlot	7 Domestic (Lawn & Garden)	11 Injection Well	4 Industrial	8 Air Conditioning	12 Other
1 Domestic	5 Public Water Supply	9 Dewatering													
2 Irrigation	6 Oil Field Water Supply	● Monitoring Well													
3 Feedlot	7 Domestic (Lawn & Garden)	11 Injection Well													
4 Industrial	8 Air Conditioning	12 Other													

5	TYPE OF BLANK CASING USED:											
<table border="0"> <tr> <td>1 Steel</td> <td>3 RMP (SR)</td> <td>5 Wrought</td> <td>7 Fiberglass</td> <td>9 Other (Specify below)</td> </tr> <tr> <td>● PVC</td> <td>4 ABS</td> <td>6 Asbestos-Cement</td> <td>8 Concrete Tile</td> <td></td> </tr> </table> Blank casing diameter 2 in. Was casing pulled? Yes No Casing height above or below land surface 36 in. If yes, how much			1 Steel	3 RMP (SR)	5 Wrought	7 Fiberglass	9 Other (Specify below)	● PVC	4 ABS	6 Asbestos-Cement	8 Concrete Tile	
1 Steel	3 RMP (SR)	5 Wrought	7 Fiberglass	9 Other (Specify below)								
● PVC	4 ABS	6 Asbestos-Cement	8 Concrete Tile									

6	GROUT PLUG MATERIAL: 1 Neat cement 2 Cement grout ● Bentonite 4 Other																					
Grout Plug Intervals: From 3 ft. to 23 ft., From ft. to ft., From to ft.																						
What is the nearest source of possible contamination:																						
<table border="0"> <tr> <td>1 Septic tank</td> <td>6 Seepage pit</td> <td>11 Fuel storage</td> <td>16 Other (specify below)</td> </tr> <tr> <td>2 Sewer lines</td> <td>7 Pit privy</td> <td>12 Fertilizer storage</td> <td></td> </tr> <tr> <td>3 Watertight sewer lines</td> <td>8 Sewage lagoon</td> <td>13 Insecticide storage</td> <td></td> </tr> <tr> <td>4 Lateral lines</td> <td>9 Feedyard</td> <td>14 Abandoned water well</td> <td></td> </tr> <tr> <td>5 Cess pool</td> <td>10 Livestock pens</td> <td>15 Oil well/Gas well</td> <td></td> </tr> </table> Direction from well? How many feet?			1 Septic tank	6 Seepage pit	11 Fuel storage	16 Other (specify below)	2 Sewer lines	7 Pit privy	12 Fertilizer storage		3 Watertight sewer lines	8 Sewage lagoon	13 Insecticide storage		4 Lateral lines	9 Feedyard	14 Abandoned water well		5 Cess pool	10 Livestock pens	15 Oil well/Gas well	
1 Septic tank	6 Seepage pit	11 Fuel storage	16 Other (specify below)																			
2 Sewer lines	7 Pit privy	12 Fertilizer storage																				
3 Watertight sewer lines	8 Sewage lagoon	13 Insecticide storage																				
4 Lateral lines	9 Feedyard	14 Abandoned water well																				
5 Cess pool	10 Livestock pens	15 Oil well/Gas well																				

FROM	TO	PLUGGING MATERIALS
0	3	Soil
3	23	Bentonite Chips

GeoCore #1300

7	CONTRACTOR'S OF LANDOWNER'S CERTIFICATION: This water well was plugged under my jurisdiction and was completed on (mo/day/year) 5/26/2006 and this record is true to the best of my knowledge and belief. Kansas Water Well Contractor's License No. 527 This Water Well Record was completed on (mo/day/year) 5/31/2006 under the business name of Geocore Inc. by (signature) <i>Bob Kel</i>	
---	--	--

INSTRUCTIONS: Use typewriter or ball point pen. Please press firmly and print clearly. Please fill in blanks, underline or circle the correct answers. Send top three copies to Kansas Department of Health and Environment, Bureau of Water, Geology Section, 1000 SW Jackson St., Ste. 420, Topeka, Kansas 66612-1367. Telephone: 785/296-5522. Send one to Water Well Owner and retain one for your records.